CO-OP MINING CO.

HUNTINGTON, UTAH

HYDROLOGY MAP

SCALE:	DRAWN BY:	DATE:
1" = 50'	C. Reynolds	6-25-01

BEAR CANYON | PLATE 7-1F

REV.	DATE	REMARKS	APPR.
1	6/25/01	Wild Horse Ridge Hydrology Added (SR98-1)	7/03/01
2	8/01/02	Digitize Map	
3	5/09/06	WHR Tank Seam As-Built/Snow Storage	
4			
5			
6			
7			
8			
9			
10			

LICENSED PROFESSIONAL ENGINEER
MARK A. REYNOLDS
5049079-2202
STATE OF UTAH

RECEIVED
NOV 09 2006
DIV. OF OIL, GAS & MINING

FILE IN Expandable 11/09/2006
Refer to Record No. 0078
in C0150025, 2006, Incoming
for additional information

SCALE 1" = 50'

50' 25' 0' 50' 100' 150'

CONTOUR INTERVAL 2'

PHOTOGRAPHY DATE SEP 3, 1991 & OCT 20, 1995

N

LEGEND
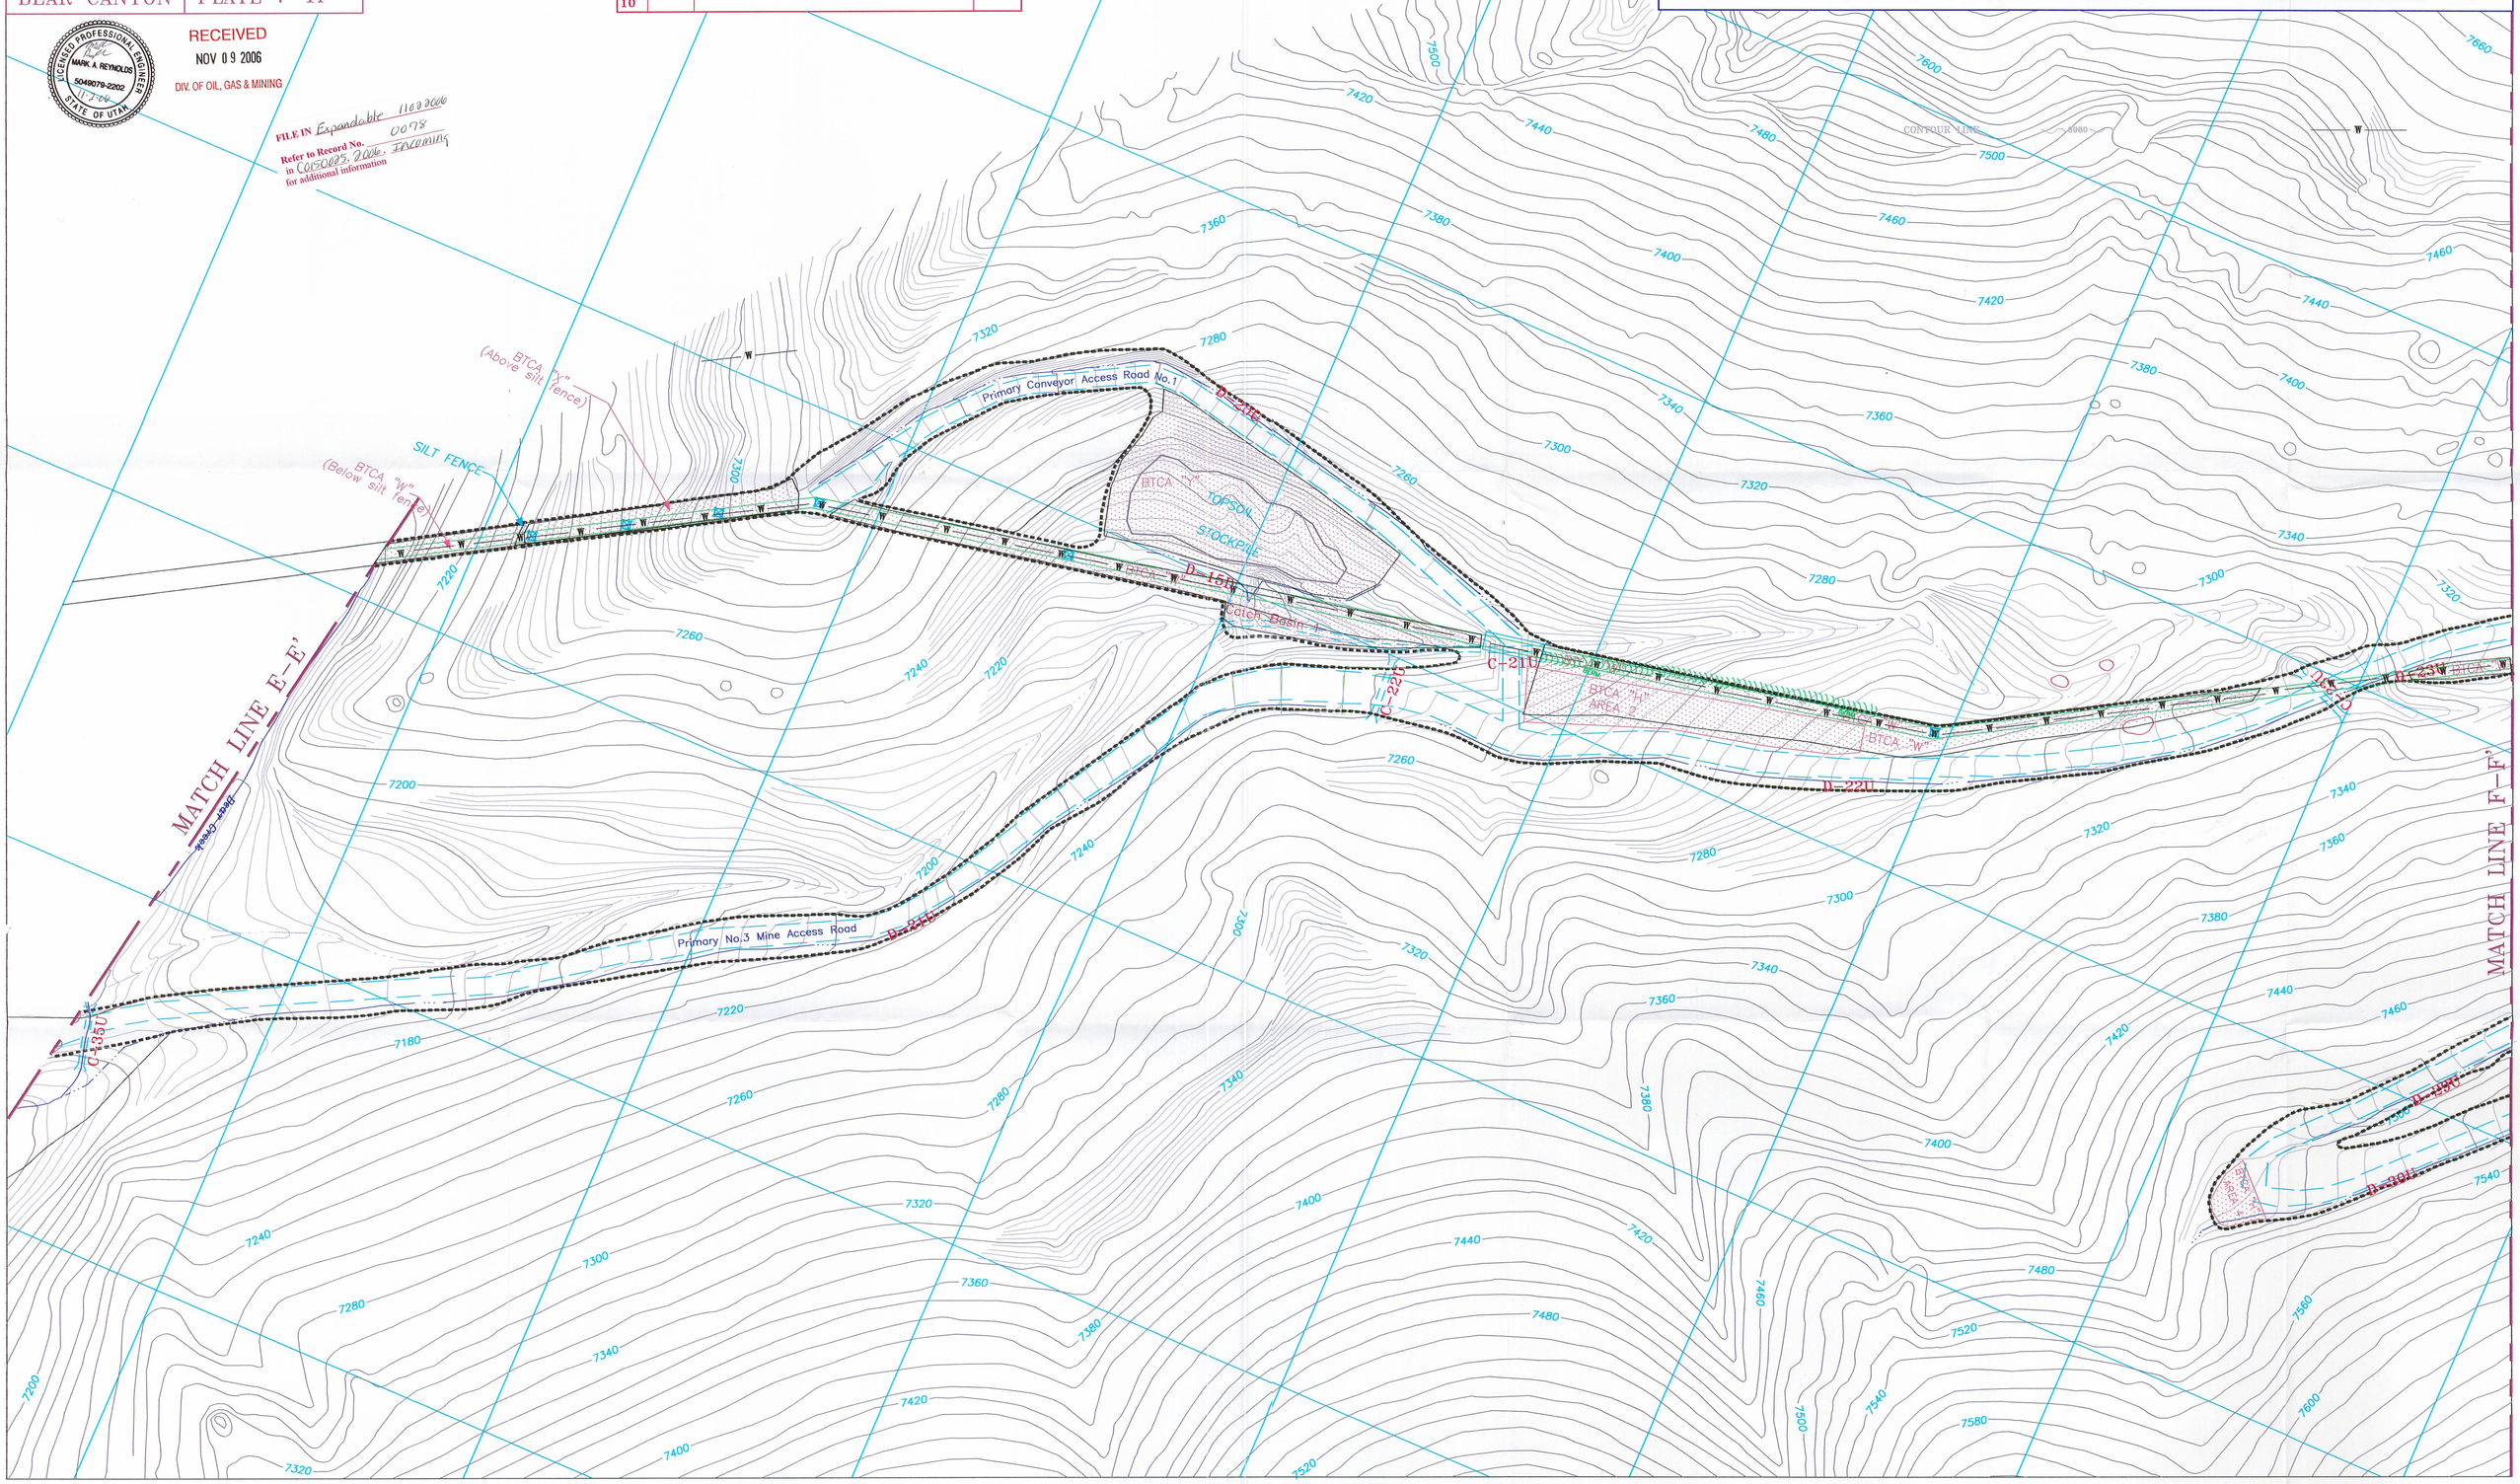
PERMIT BOUNDARY		CONTOUR LINE	6980	PAVEMENT	
DISTURBED AREA		UNPAVED ROADS		WATER LINES	W
PRE-1977 DISTURBANCE		SECTION LINE		DRAINAGE	
CULVERTS		SEE PLATES 7-1 FOR HYDROLOGY		POWER POLES	
				STREAM BUFFER ZONE MARKERS	⊕