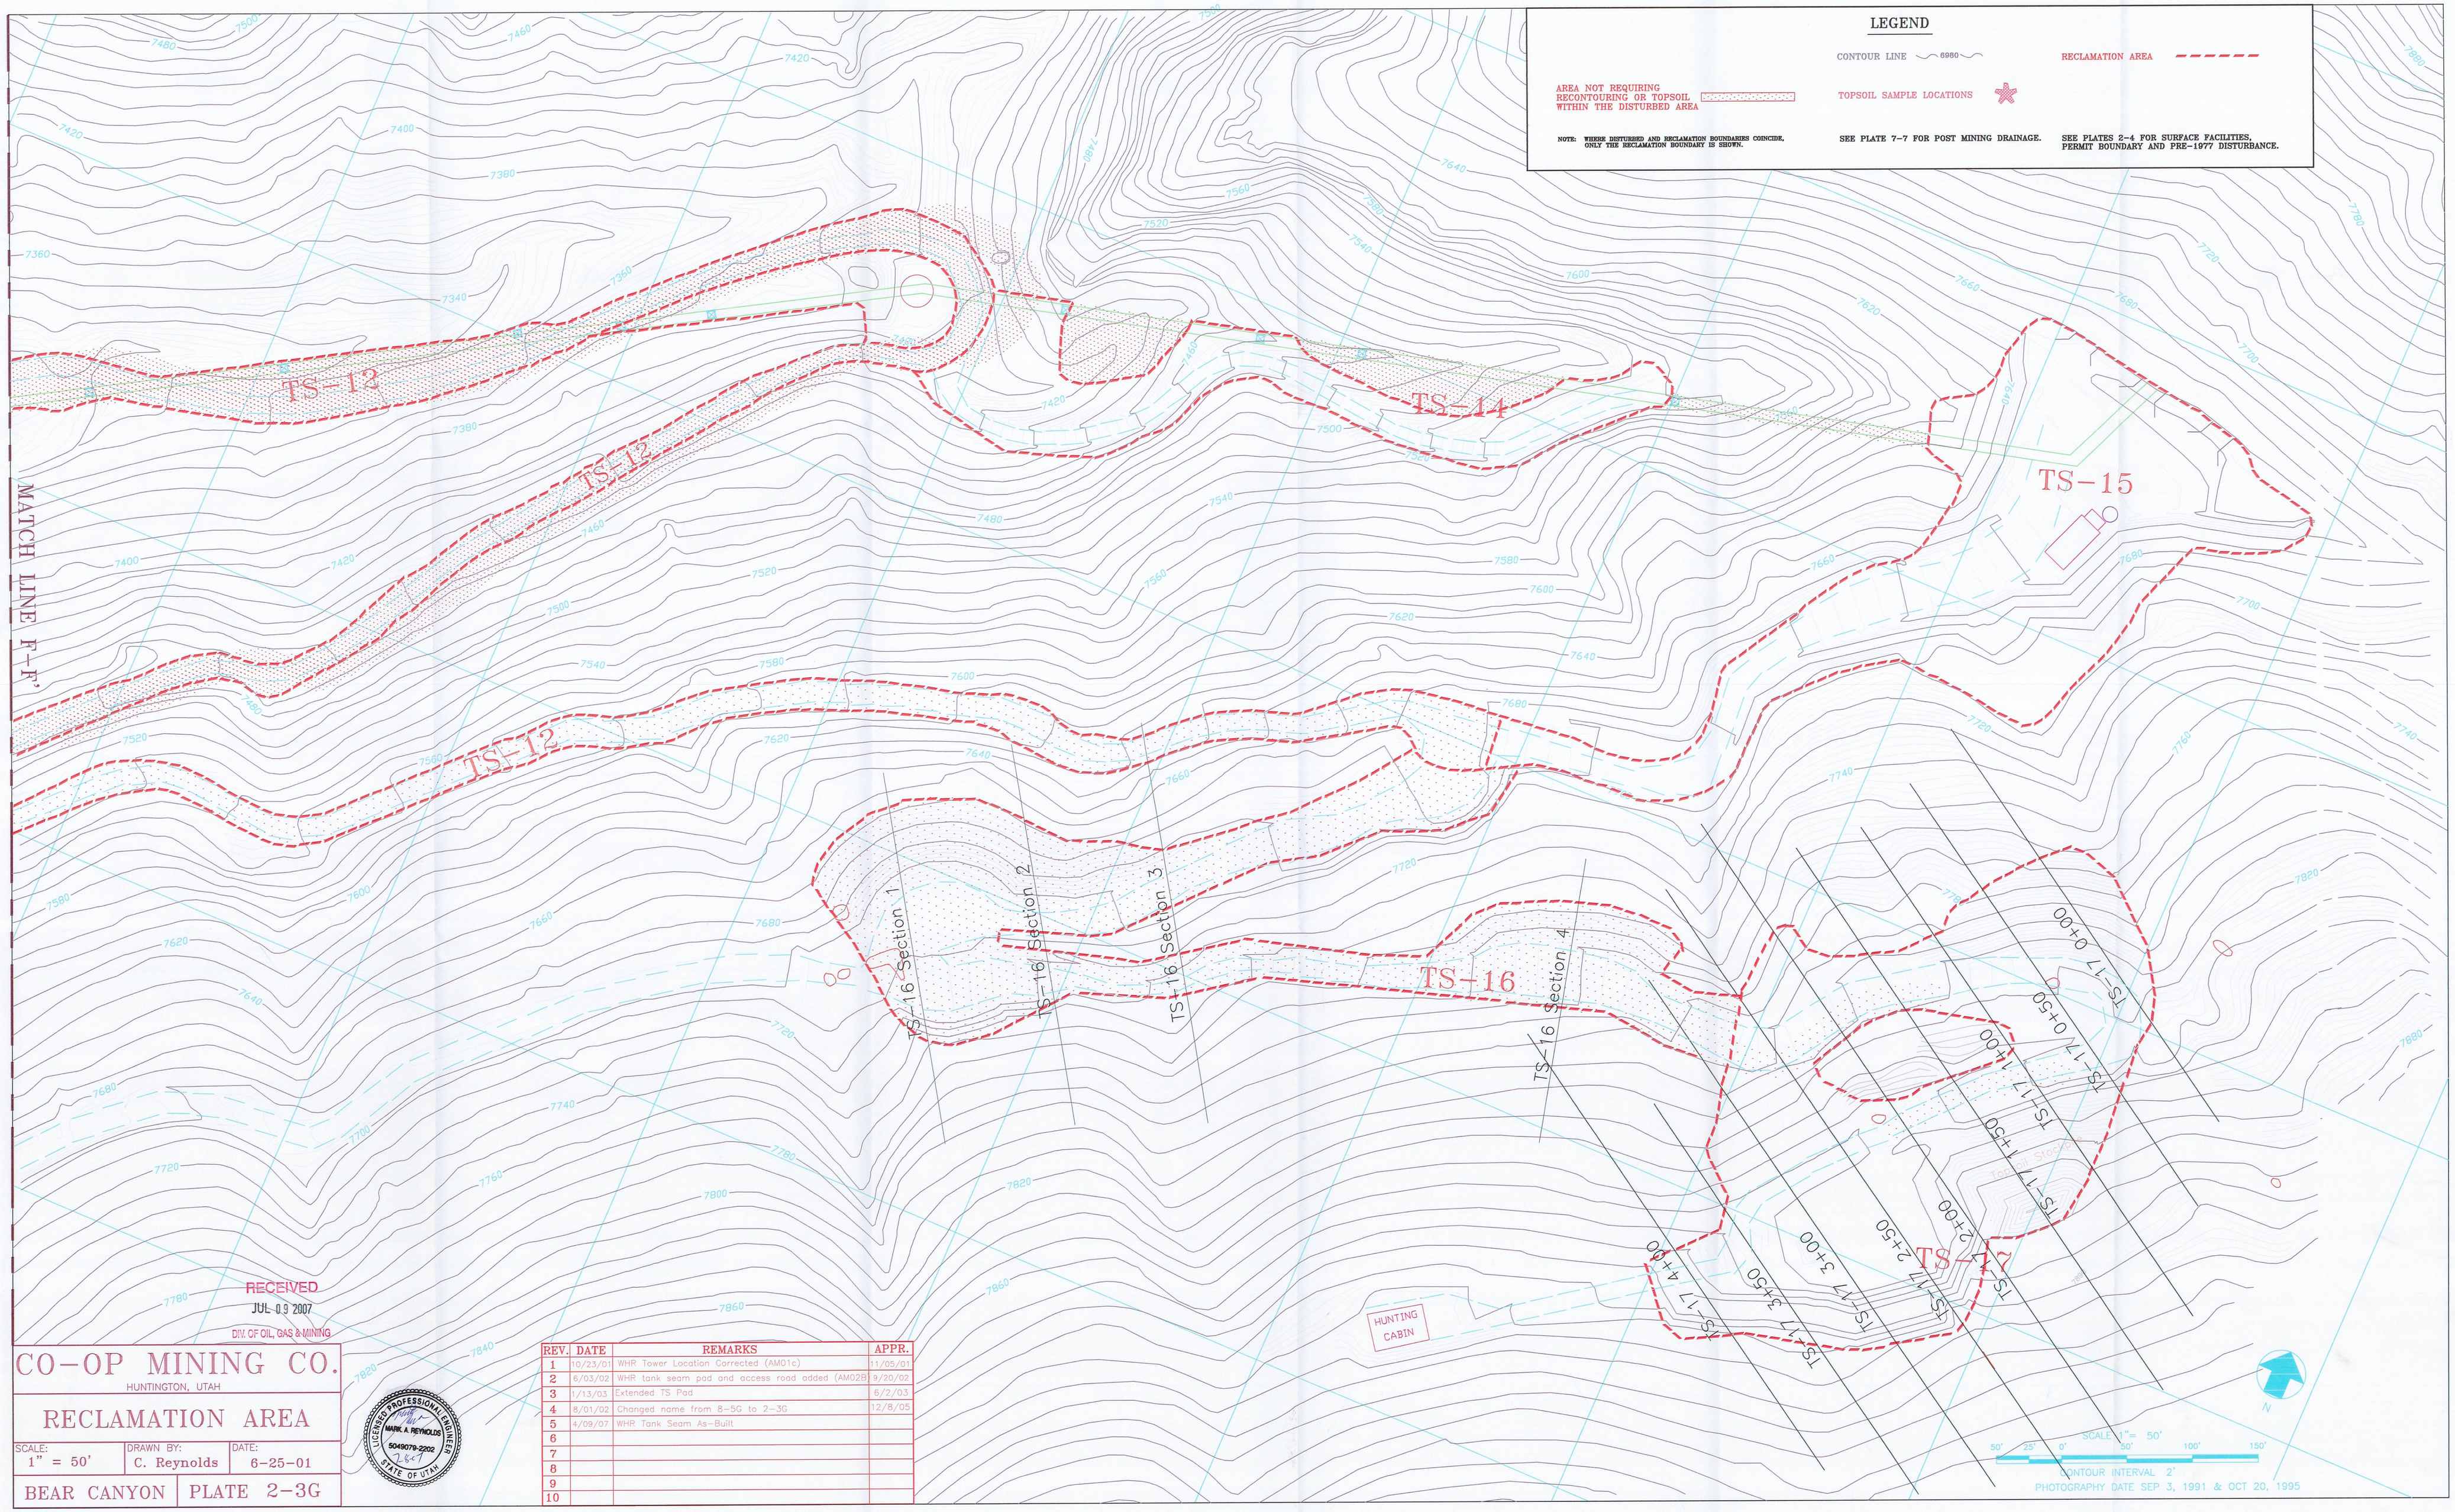

RECEIVED
JUL 09 2007
DIV. OF OIL, GAS & MINING

LICENSED PROFESSIONAL ENGINEER
MARK A. REYNOLDS
5049079-2202
STATE OF UTAH

REV.	DATE	REMARKS	APPR.
1	10/23/01	WHR Tower Location Corrected (AM01c)	11/05/01
2	6/03/02	WHR tank seam pad and access road added (AM02B)	9/20/02
3	1/13/03	Extended TS Pad	6/2/03
4	8/01/02	Changed name from B-5G to 2-3G	12/8/05
5	4/09/07	WHR Tank Seam As-Built	
6			
7			
8			
9			
10			

CO-OP MINING CO.

HUNTINGTON, UTAH

RECLAMATION AREA

SCALE:	DRAWN BY:	DATE:
1" = 50'	C. Reynolds	6-25-01

BEAR CANYON | PLATE 2-3G