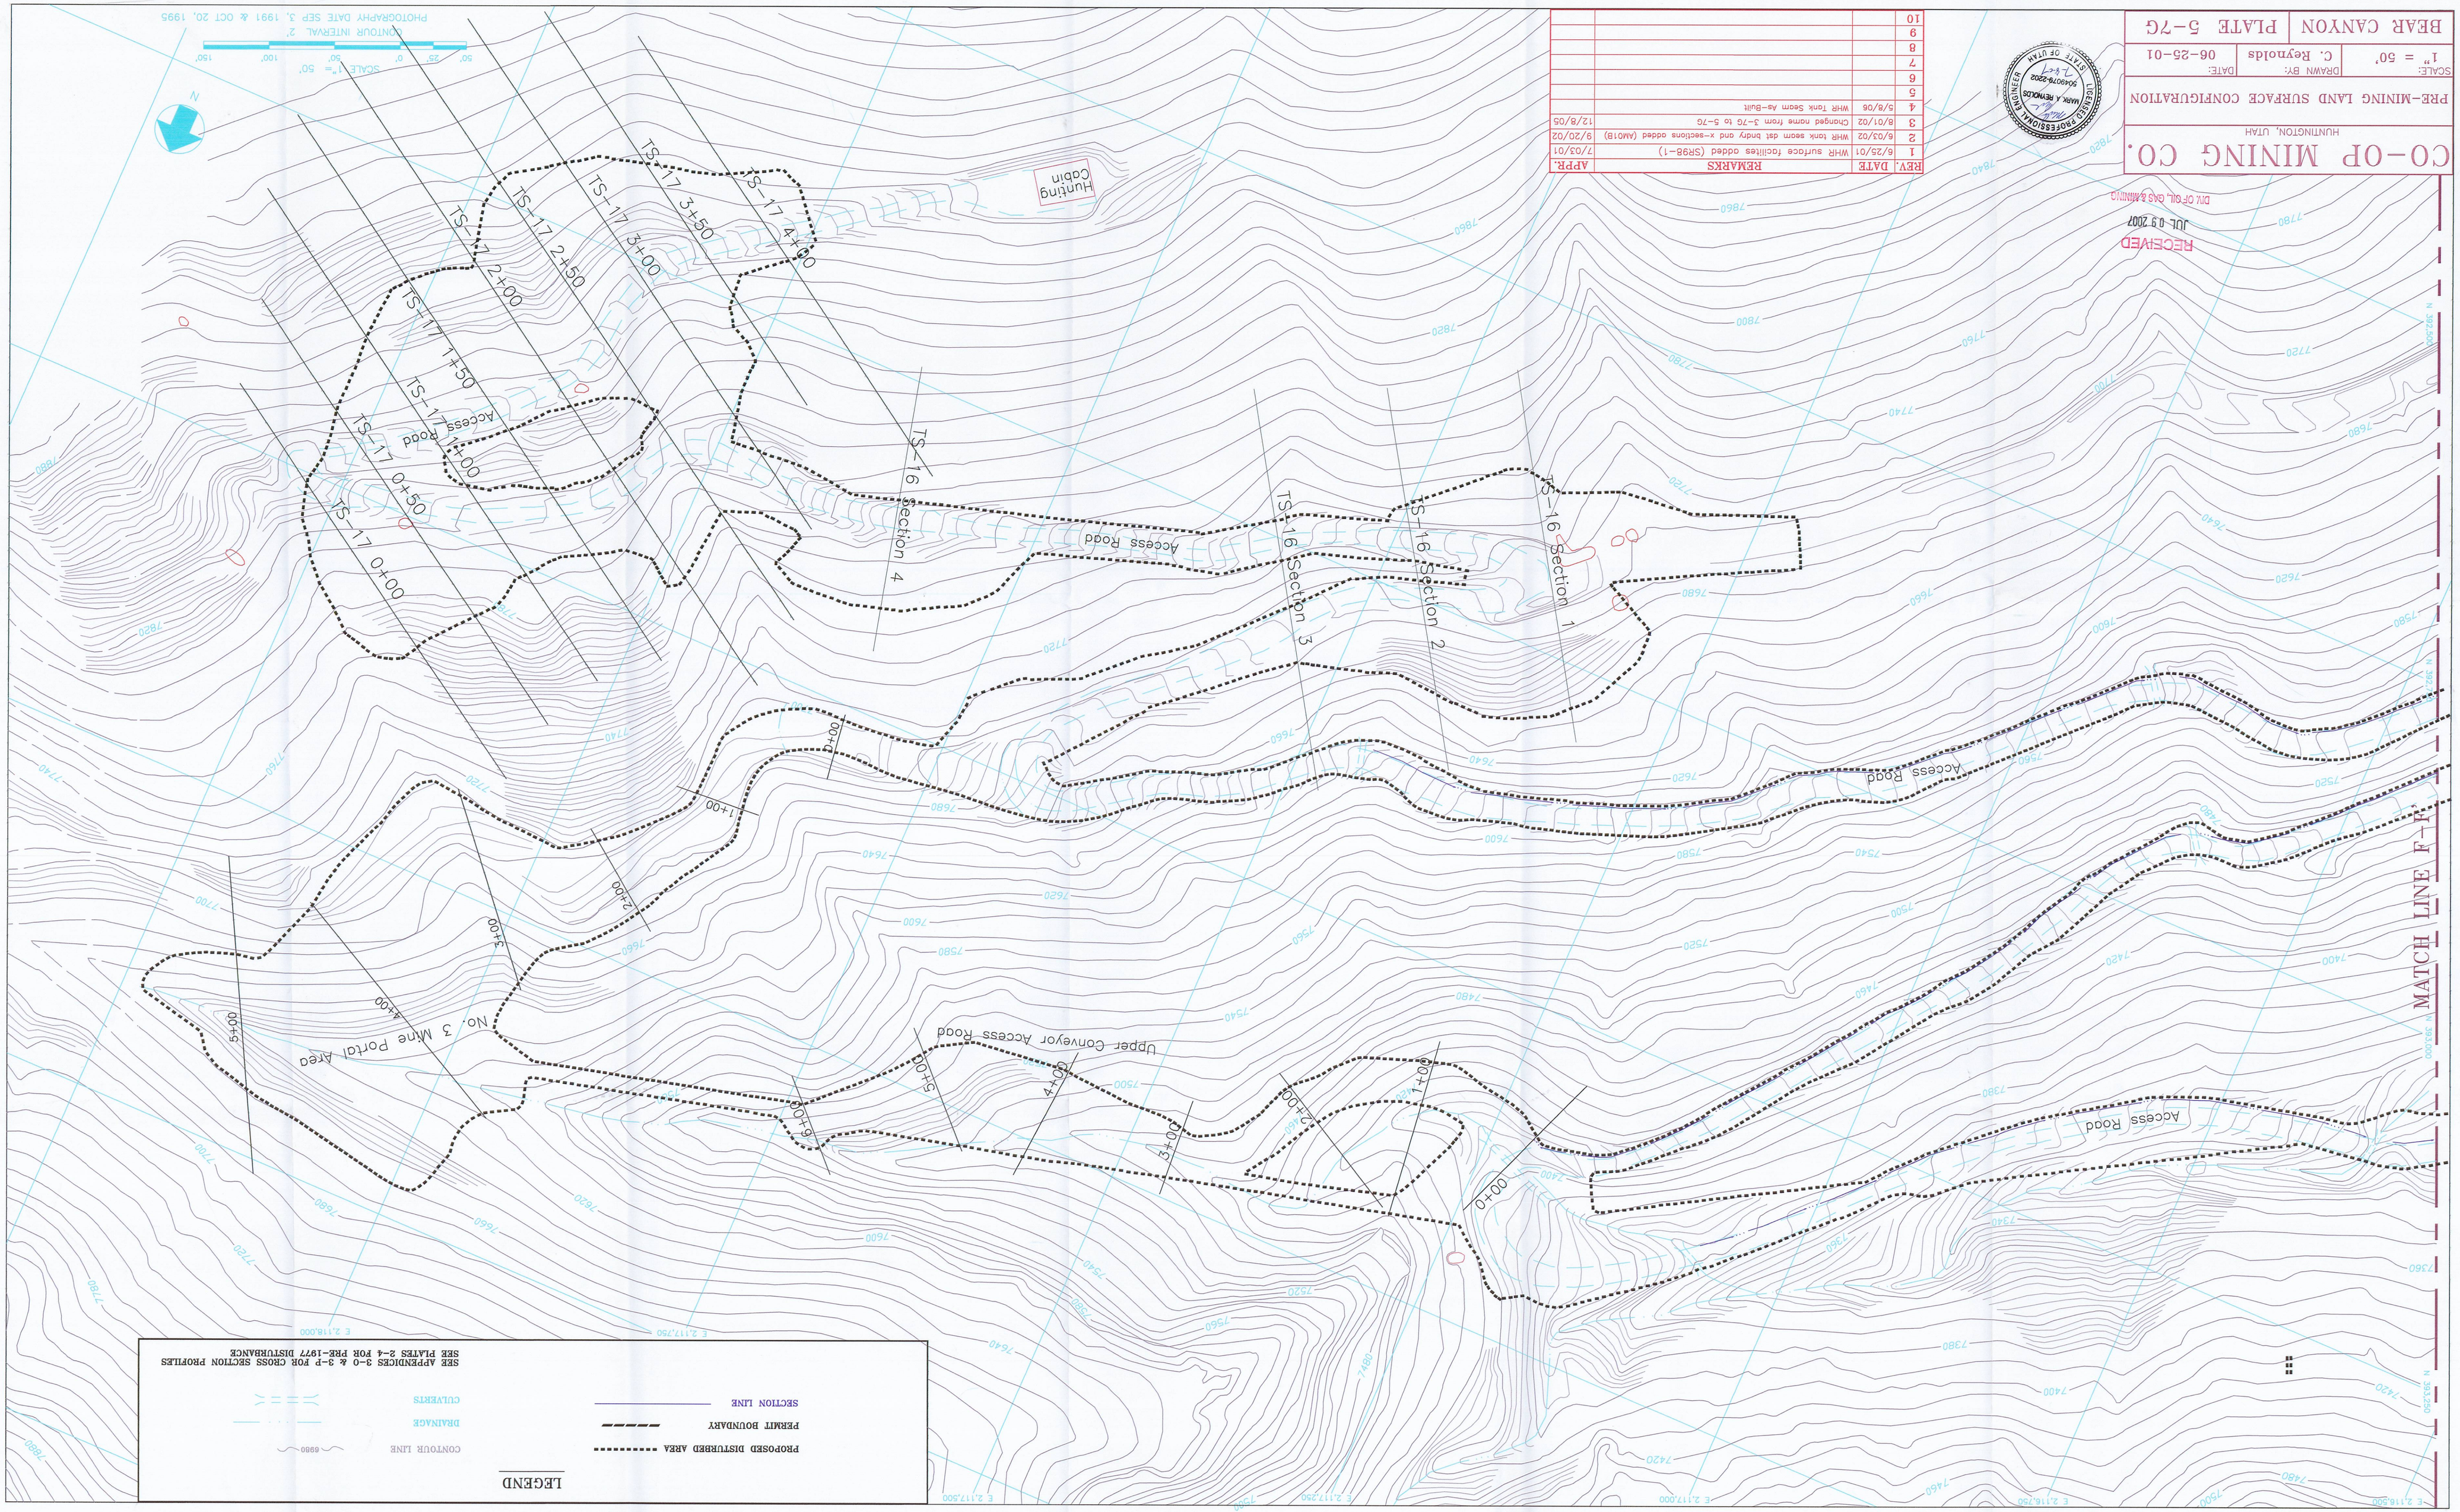

CO-OP MINING CO.
HUNTINGTON, UTAH
PRE-MINING LAND SURFACE CONFIGURATION
SCALE: 1" = 50'
DRAWN BY: C. Reynolds
DATE: 06-25-01
BEAR CANYON
PLATE 5-7G
LIGENED PROFESSIONAL ENGINEER
MARK A. REYNOLDS
5049079-2202
STATE OF UTAH
RECEIVED
JUL 09 2007
DIV. OF OIL, GAS & MINING
REV. | DATE | REMARKS | APPR.
1 | 6/25/01 | WHR surface facilities added (SR98-1) | 7/03/01
2 | 6/03/02 | WHR tank seam dst bndry and x-sections added (AM01B) | 9/20/02
3 | 8/01/02 | Changed name from 3-7G to 5-7G | 12/8/05
4 | 5/8/06 | WHR Tank Seam As-Built
5
6
7
8
9
10
PHOTOGRAPHY DATE SEP 3, 1991 & OCT 20, 1995
CONTOUR INTERVAL 2'
SCALE 1" = 50'
Hunting Cabin
Access Road
Upper Conveyor Access Road
No. 3 Mine Portal Area
TS-16 Section 1
TS-16 Section 2
TS-16 Section 3
TS-16 Section 4
TS-17 0+00
TS-17 0+50
TS-17 1+00
TS-17 1+50
TS-17 2+00
TS-17 2+50
TS-17 3+00
TS-17 3+50
TS-17 4+00
MATCH LINE F-F'
LEGEND
PROPOSED DISTURBED AREA
PERMIT BOUNDARY
SECTION LINE
CONTOUR LINE
DRAINAGE
CULVERTS
SEE APPENDICES 3-O & 3-P FOR CROSS SECTION PROFILES
SEE PLATES 2-4 FOR PRE-1977 DISTURBANCE