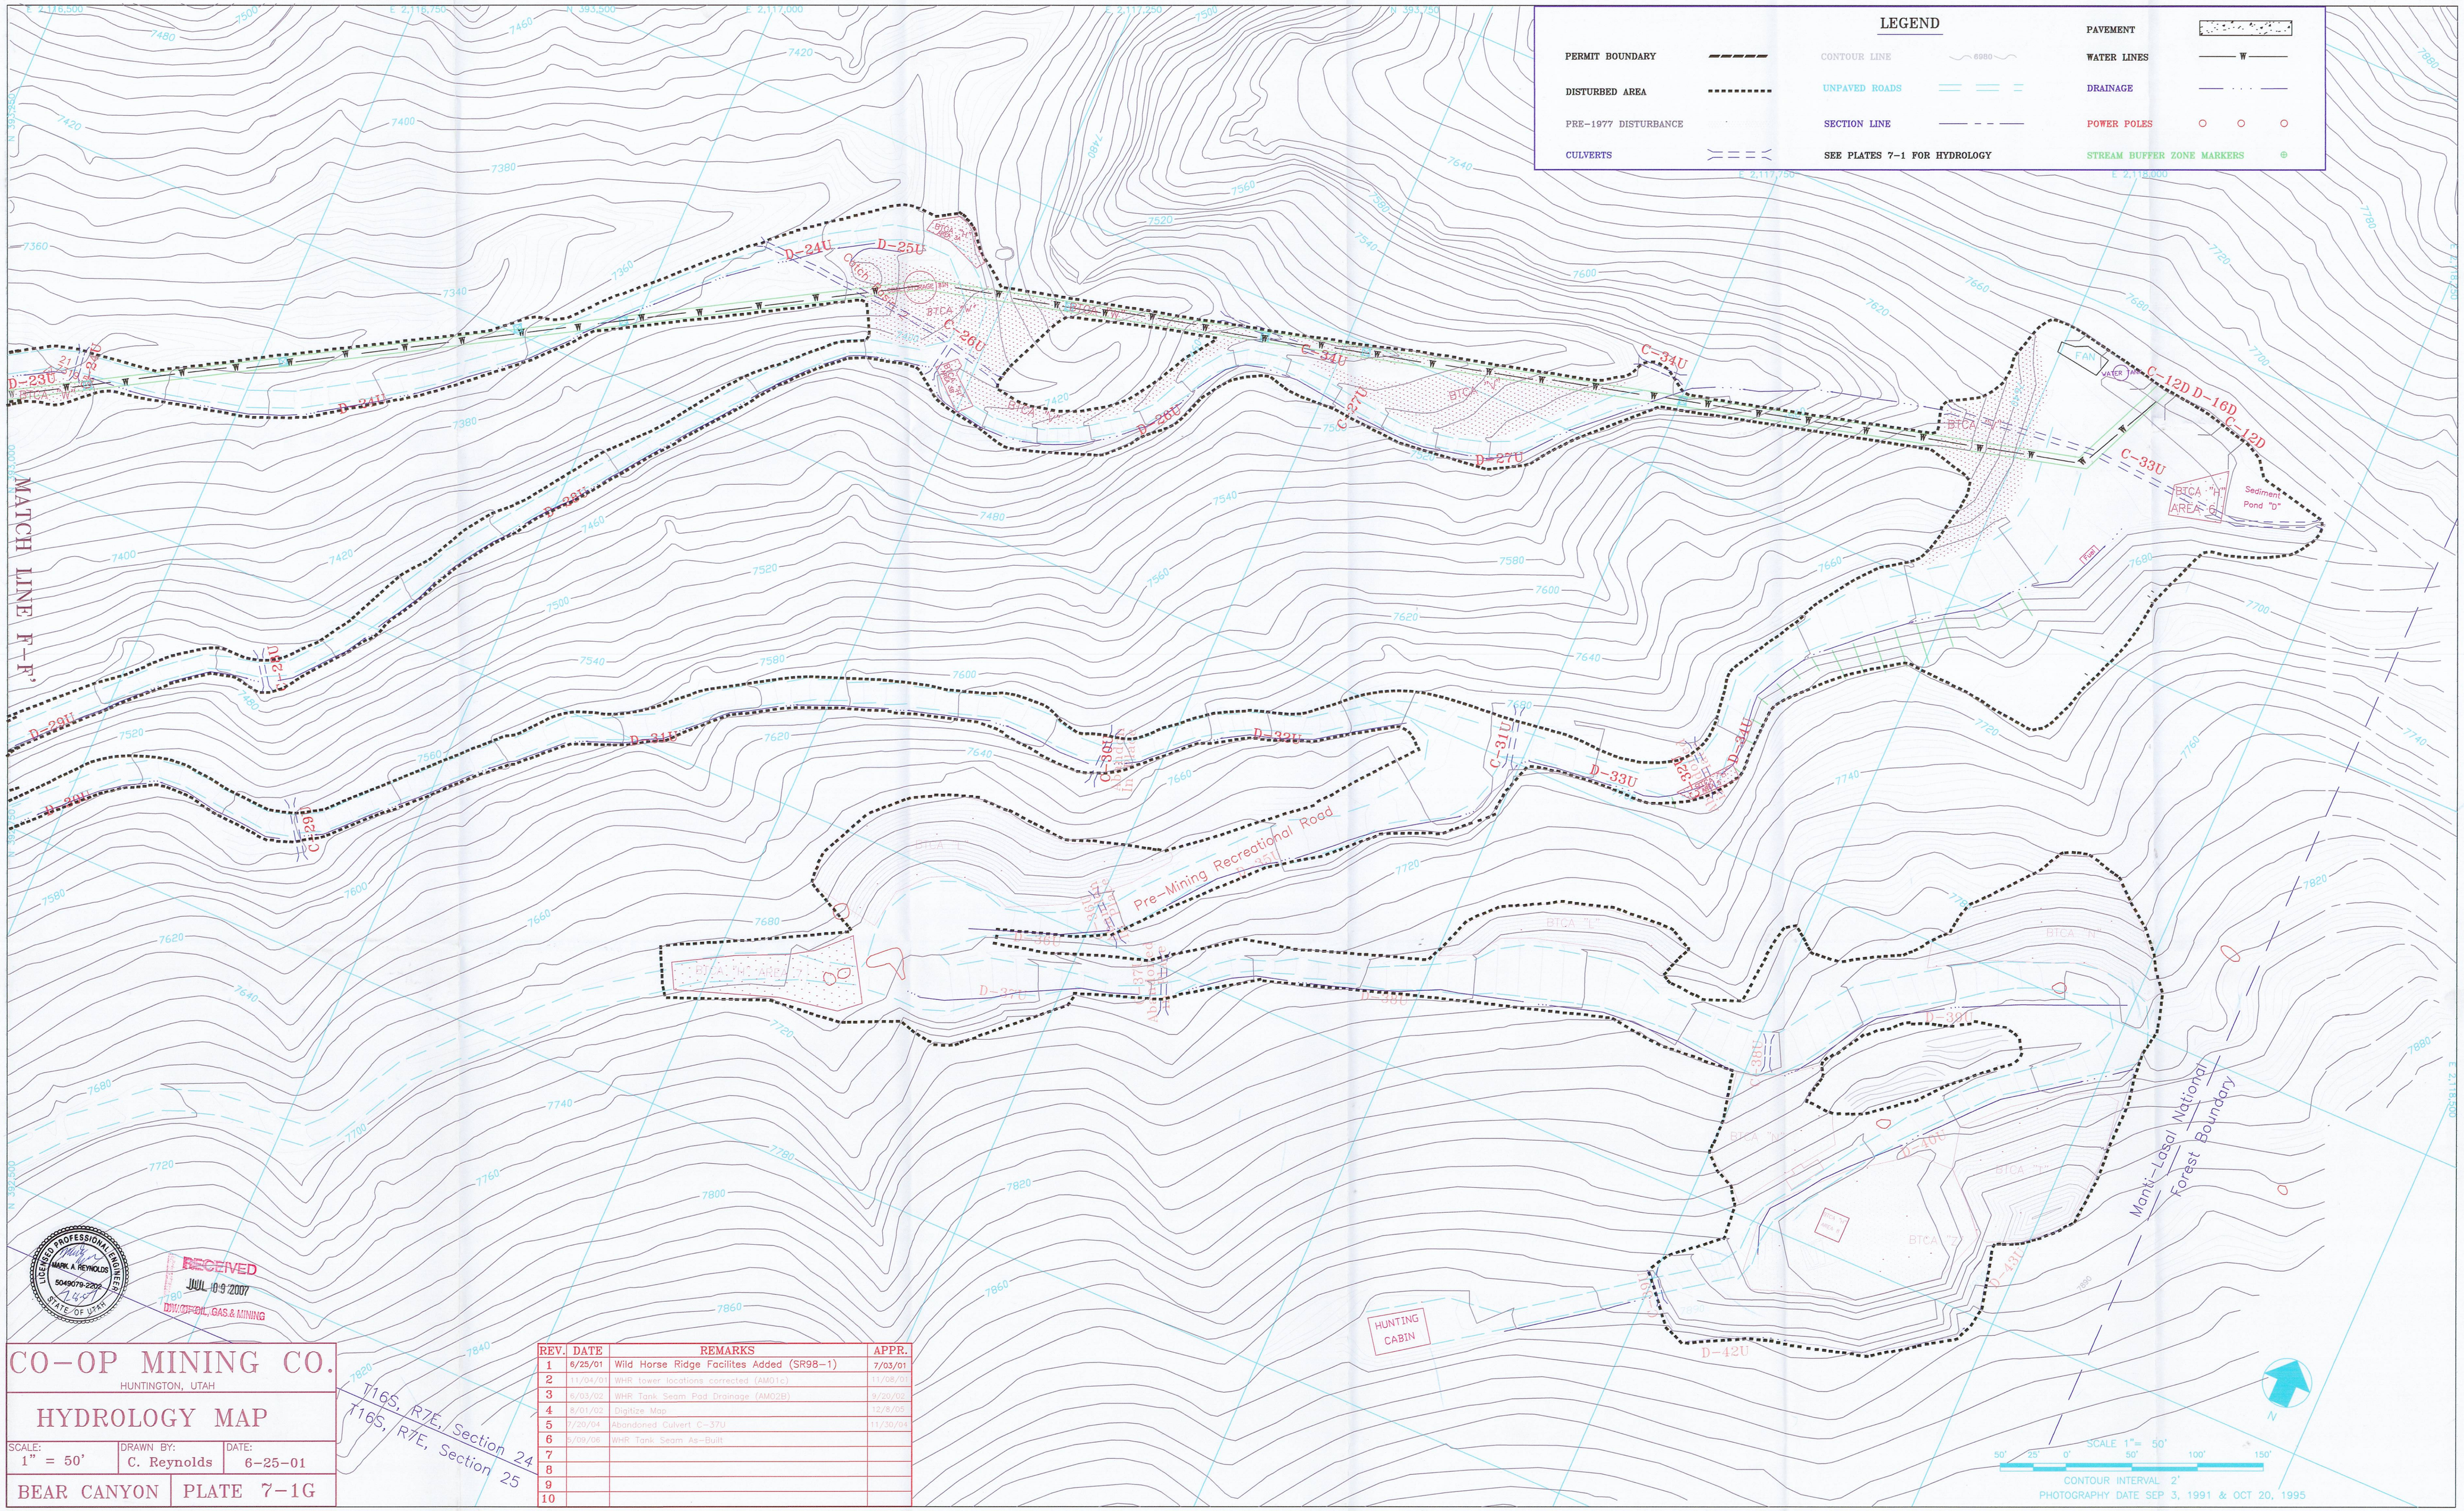

CO-OP MINING CO.

HUNTINGTON, UTAH

HYDROLOGY MAP

SCALE:	DRAWN BY:	DATE:
1" = 50'	C. Reynolds	6-25-01

BEAR CANYON | PLATE 7-1G

REV.	DATE	REMARKS	APPR.
1	6/25/01	Wild Horse Ridge Facilites Added (SR98-1)	7/03/01
2	11/04/01	WHR tower locations corrected (AM01C)	11/08/01
3	6/03/02	WHR Tank Seam Pad Drainage (AM02B)	6/20/02
4	8/01/02	Digitize Map	12/8/05
5	7/20/04	Abandoned Culvert C-37U	11/30/05
6	5/09/06	WHR Tank Seam As-Built	
7			
8			
9			
10			