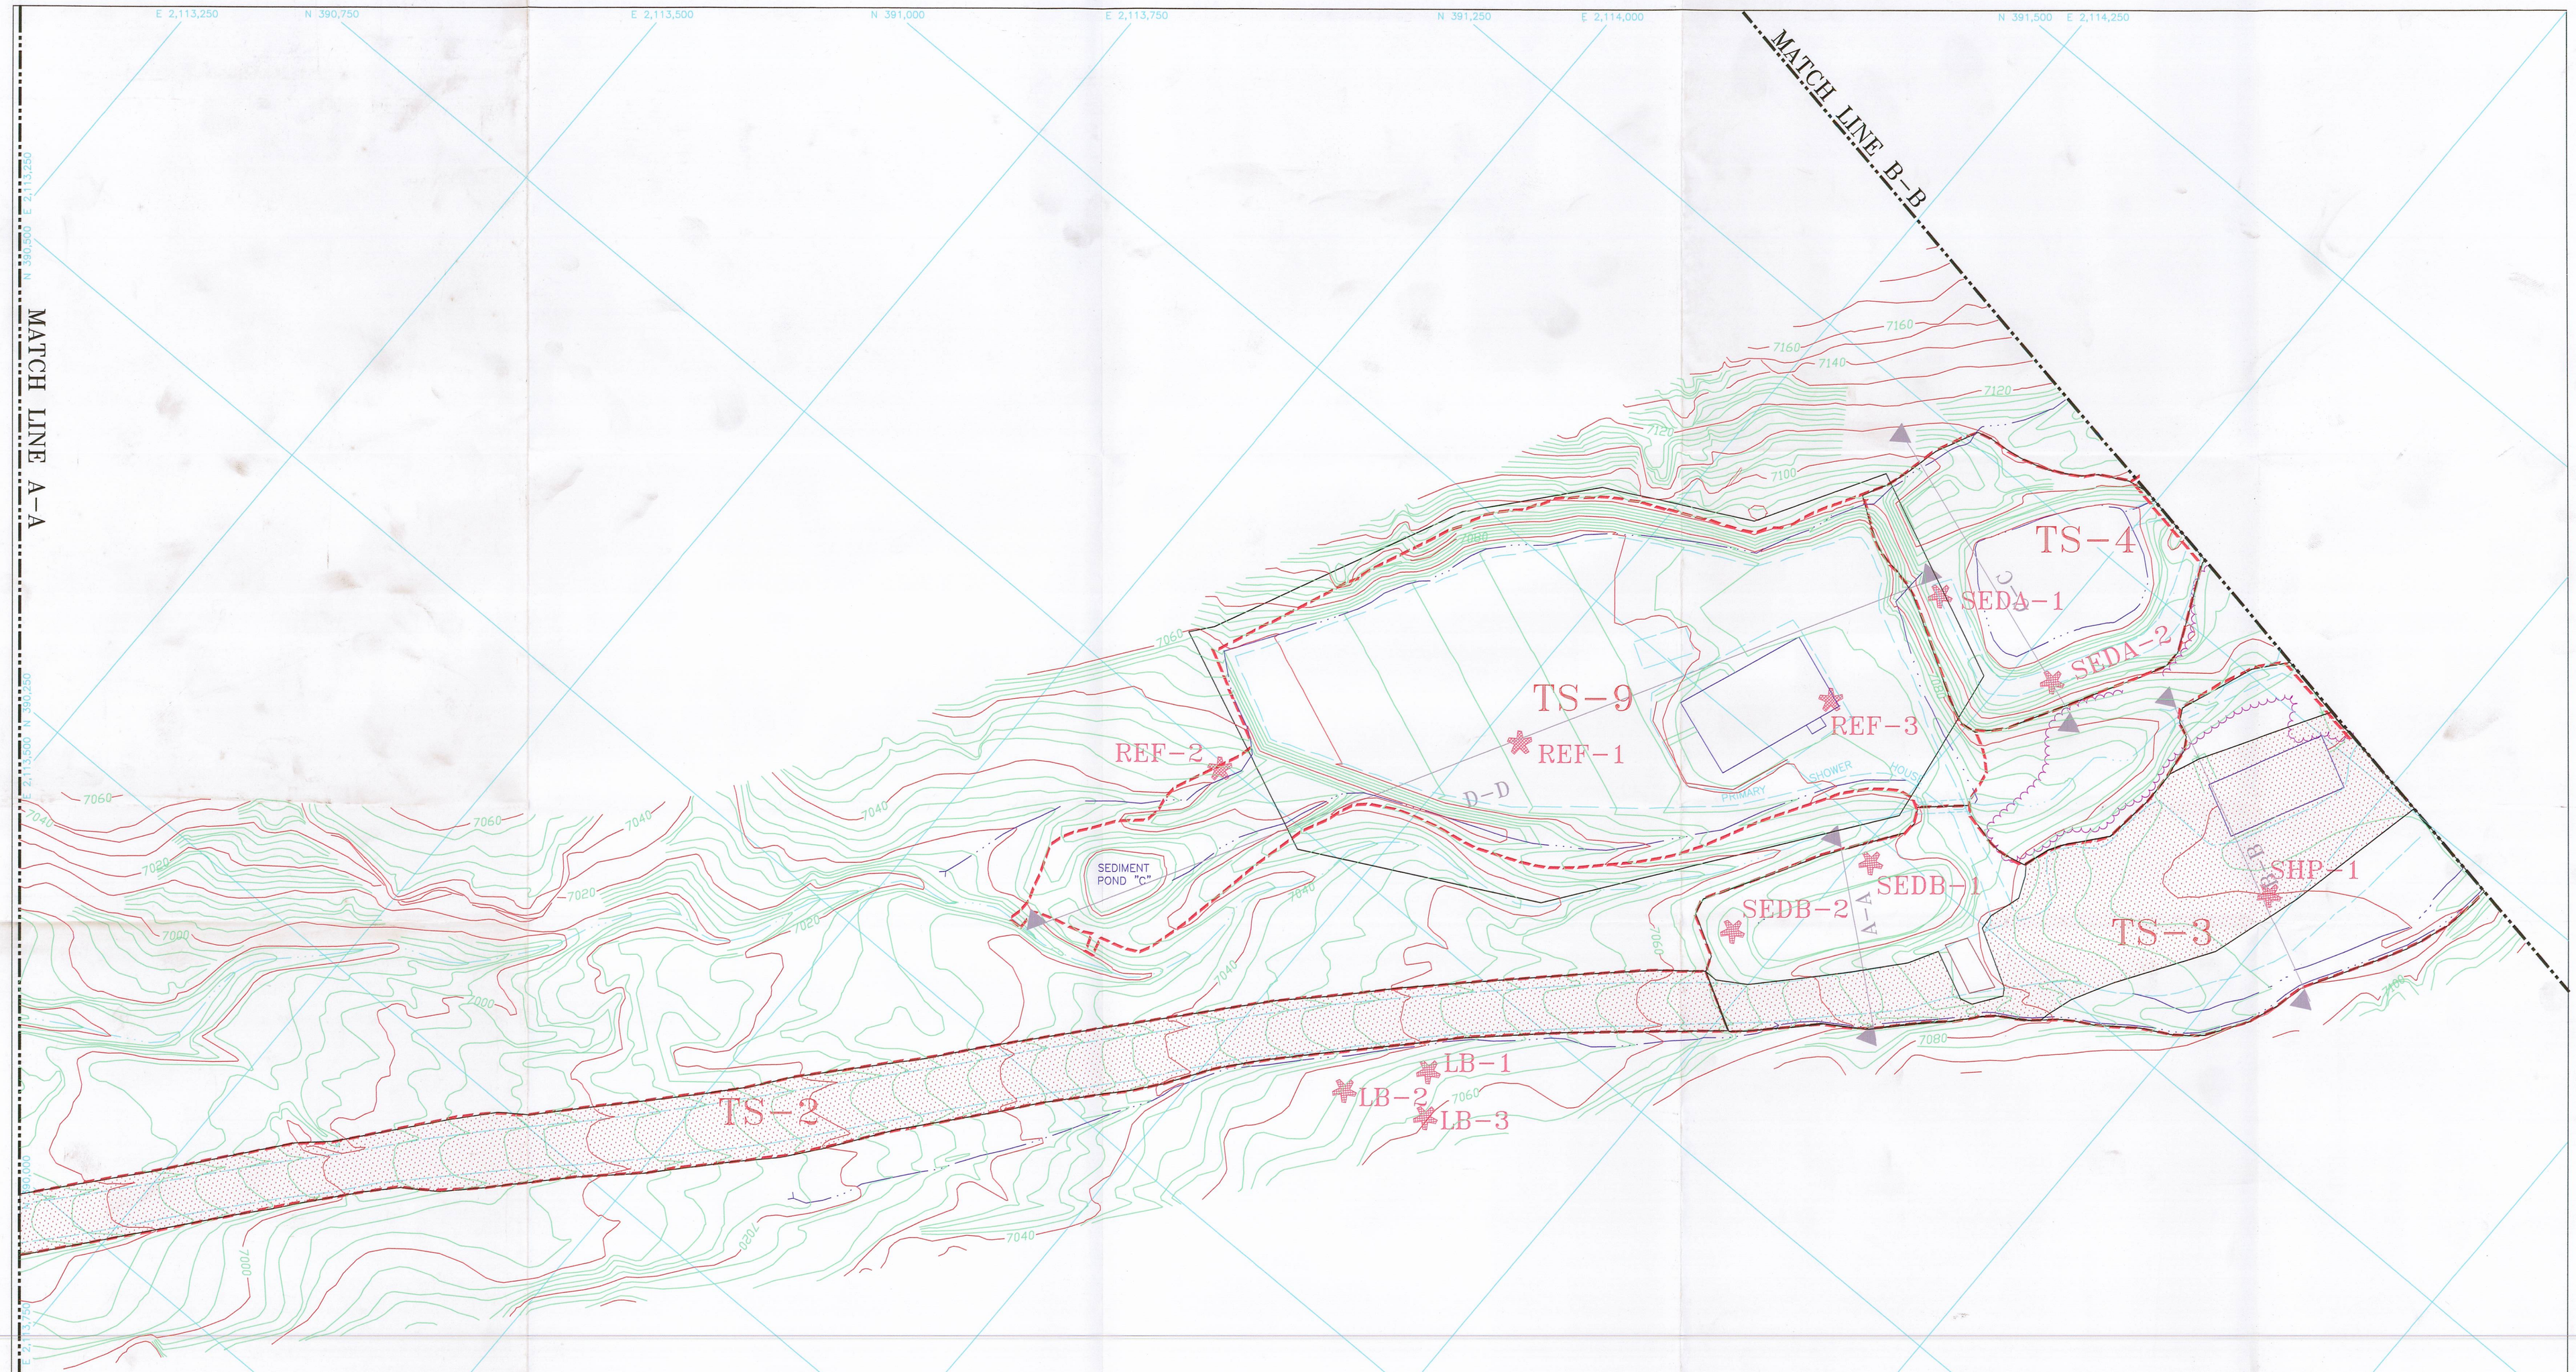


RECEIVED
MAY 22 2008
DIV. OF OIL, GAS & MINING

# CO-OP MINING CO.

HUNTINGTON, UTAH

## RECLAMATION AREA

| SCALE: | DRAWN BY: | DATE: |
|---|---|---|
| 1"= 50' | C. REYNOLDS | 5/13/91 |

BEAR CANYON | PLATE 2-3B

| REV. | DATE | REMARKS | APPR. |
|---|---|---|---|
| 1 | 10-91 | Soil Sample Locations Plotted | 10-91 |
| 2 | 4-28-92 | Lump Coal Storage Proposal Added | 7-07-92 |
| 3 | 4-28-92 | Sed. Pond "A" Dist. Bound. Corrected | 9-18-92 |
| 4 | 11-20-92 | Shower House Proposal Added (92H) | 2-09-93 |
| 5 | 2-23-96 | Updated for Shower House Pad As-Builts (96A) | 7-05-96 |
| 6 | 7-22-96 | D-BD Water Bar Concrete Crossing Added (96C) | 9-04-96 |
| 7 | 10-13-01 | Added TS-5, TS-4 boundary lines, and cross-sections (01A) | 11-13-01 |
| 8 | 8/01/02 | Changed name from 8-5B to 2-3B. | 12-8-05 |
| 9 | 5/09/08 | Boundary change | |
| 10 | | | |

## LEGEND

Cross-Sections (Apendix 3L)

DISTURBED AREA

CONTOUR LINE 6980

RECLAMATION AREA

AREA NOT REQUIRING RECONTOURING OR TOPSOIL WITHIN THE DISTURBED AREA

TOPSOIL SAMPLE LOCATIONS

NOTE: WHERE DISTURBED AND RECLAMATION BOUNDARIES COINCIDE, ONLY THE RECLAMATION BOUNDARY IS SHOWN.

SEE PLATE 7-7 FOR POST MINING DRAINAGE.

SEE PLATES 2-4 FOR SURFACE FACILITIES, PERMIT BOUNDARY AND PRE-1977 DISTURBANCE.

File in:
☐ Confidential
☐ Shelf
☒ Expandable
Refer to Record No. C0/3 Date 5/15/2008
In C0070036 2008 Incoming
For additional information

SCALE 1"= 50'
50' 25' 0 50' 100' 150'

CONTOUR INTERVAL 2'
PHOTOGRAPHY DATE NOV. 11, 1990