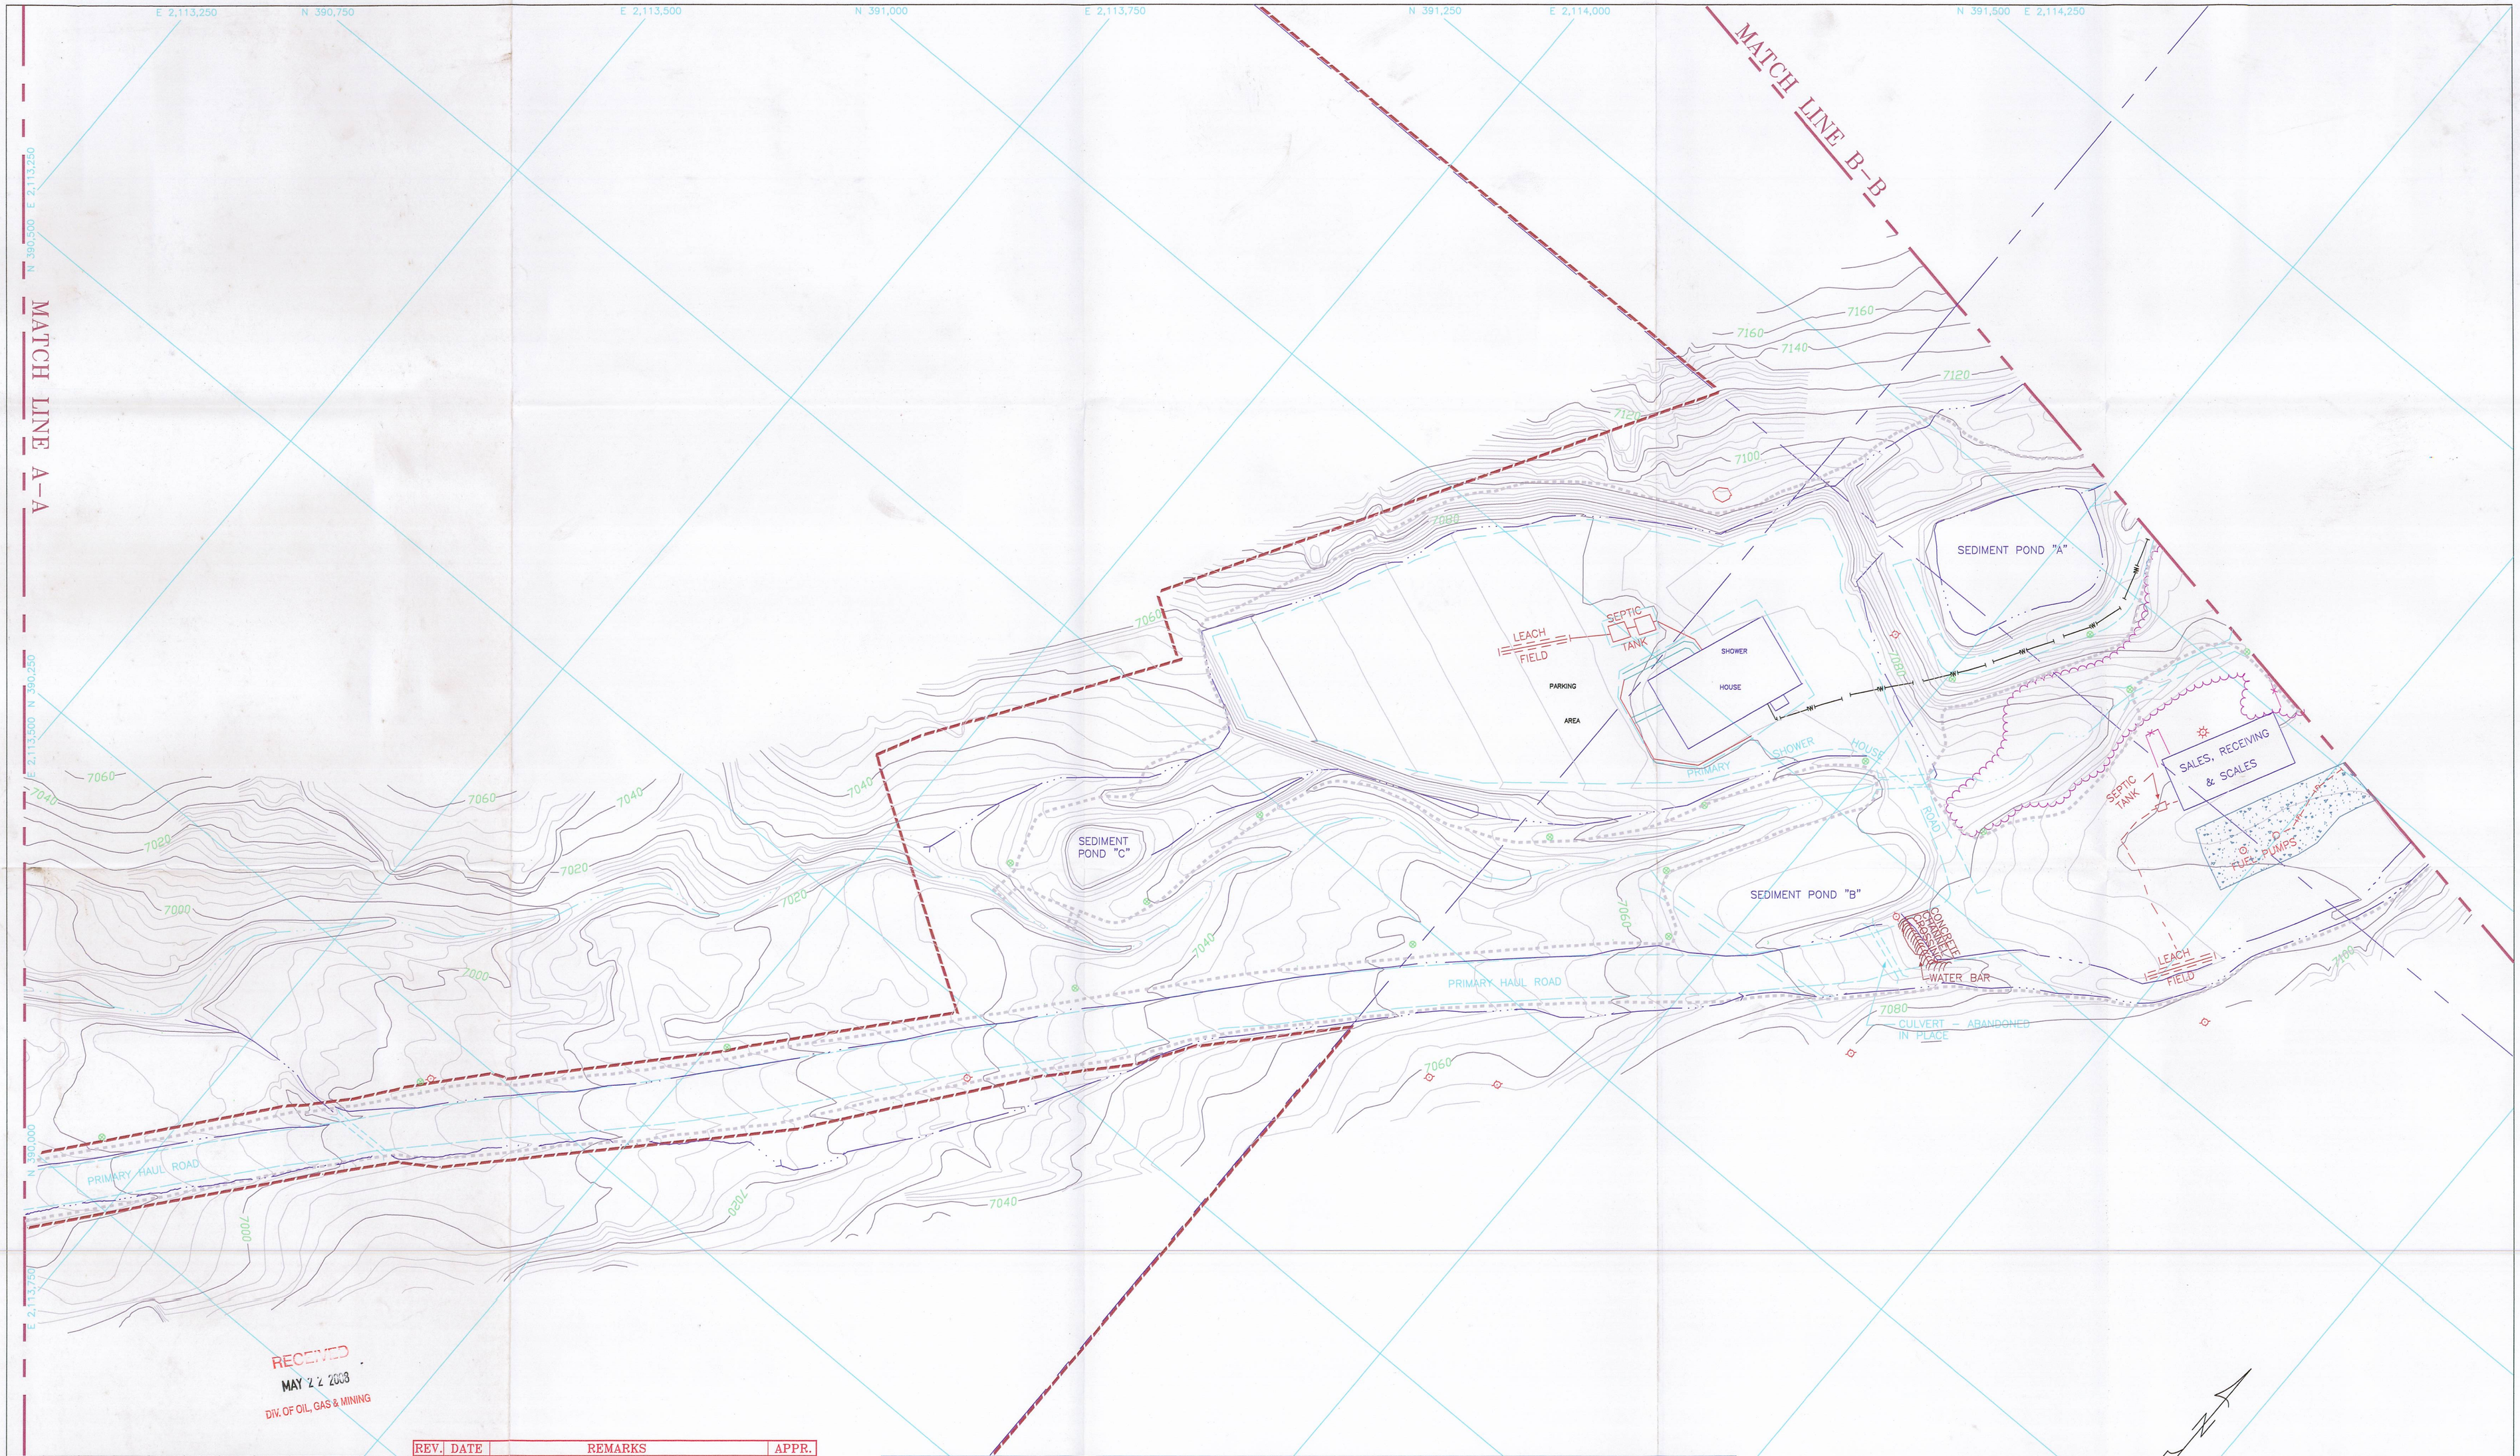

RECEIVED
MAY 22 2008
DIV. OF OIL, GAS & MINING

CO-OP MINING CO.

HUNTINGTON, UTAH

SURFACE FACILITIES

SCALE:	DRAWN BY:	DATE:
1" = 50'	C. Reynolds	8/26/91

BEAR CANYON | PLATE 5-2B

REV.	DATE	REMARKS	APPR.
1	4-28-92	Lump Coal Storage Proposal Added	7-07-92
2	4-28-92	Sediment Pond "A" Disturbed Boundary Corrected	9-18-92
3	11-20-92	Shower House Proposal Added (92H)	2-09-93
4	8-24-94	Shower House Waterline Added (94C)	10-19-94
5	2-23-96	Map Updated For Shower House Pad As-Builts (96A)	7-05-96
6	7-22-96	D-8D Water Bar Concrete Crossing Added (96C)	9-04-96
7	6-23-97	Scalehouse Pavement Added (97B)	11-03-97
8	12-30-99	Steel Bridge Structure/Contours Near Bath House (00A)	2-10-00
9	6-25-01	Permit Boundary Changed for WHR Addition (SR98-1)	7-3-01
10	8/01/02	Changed name from 2-4B to 5-2B	12-8-05
11	9-09-08	Boundary change	

LEGEND

PERMIT BOUNDARY		CONTOUR LINE	6980	PAVEMENT	
DISTURBED AREA		UNPAVED ROADS		WATER LINES	W
PRE-1977 DISTURBANCE		SECTION LINE		DRAINAGE	
CULVERTS		SEE PLATES 7-1 FOR HYDROLOGY		POWER LINES	
				STREAM BUFFER ZONE MARKERS	

File in:
☐ Confidential
☐ Shelf
☒ Expandable
Refer to Record No. 0018 Date 05/15/2008
In C/0/5 0025 2005 Incoming
For additional information

SCALE 1"= 50'
50' 25' 0 50' 100' 150'
CONTOUR INTERVAL 2'
PHOTOGRAPHY DATE NOV. 11, 1990