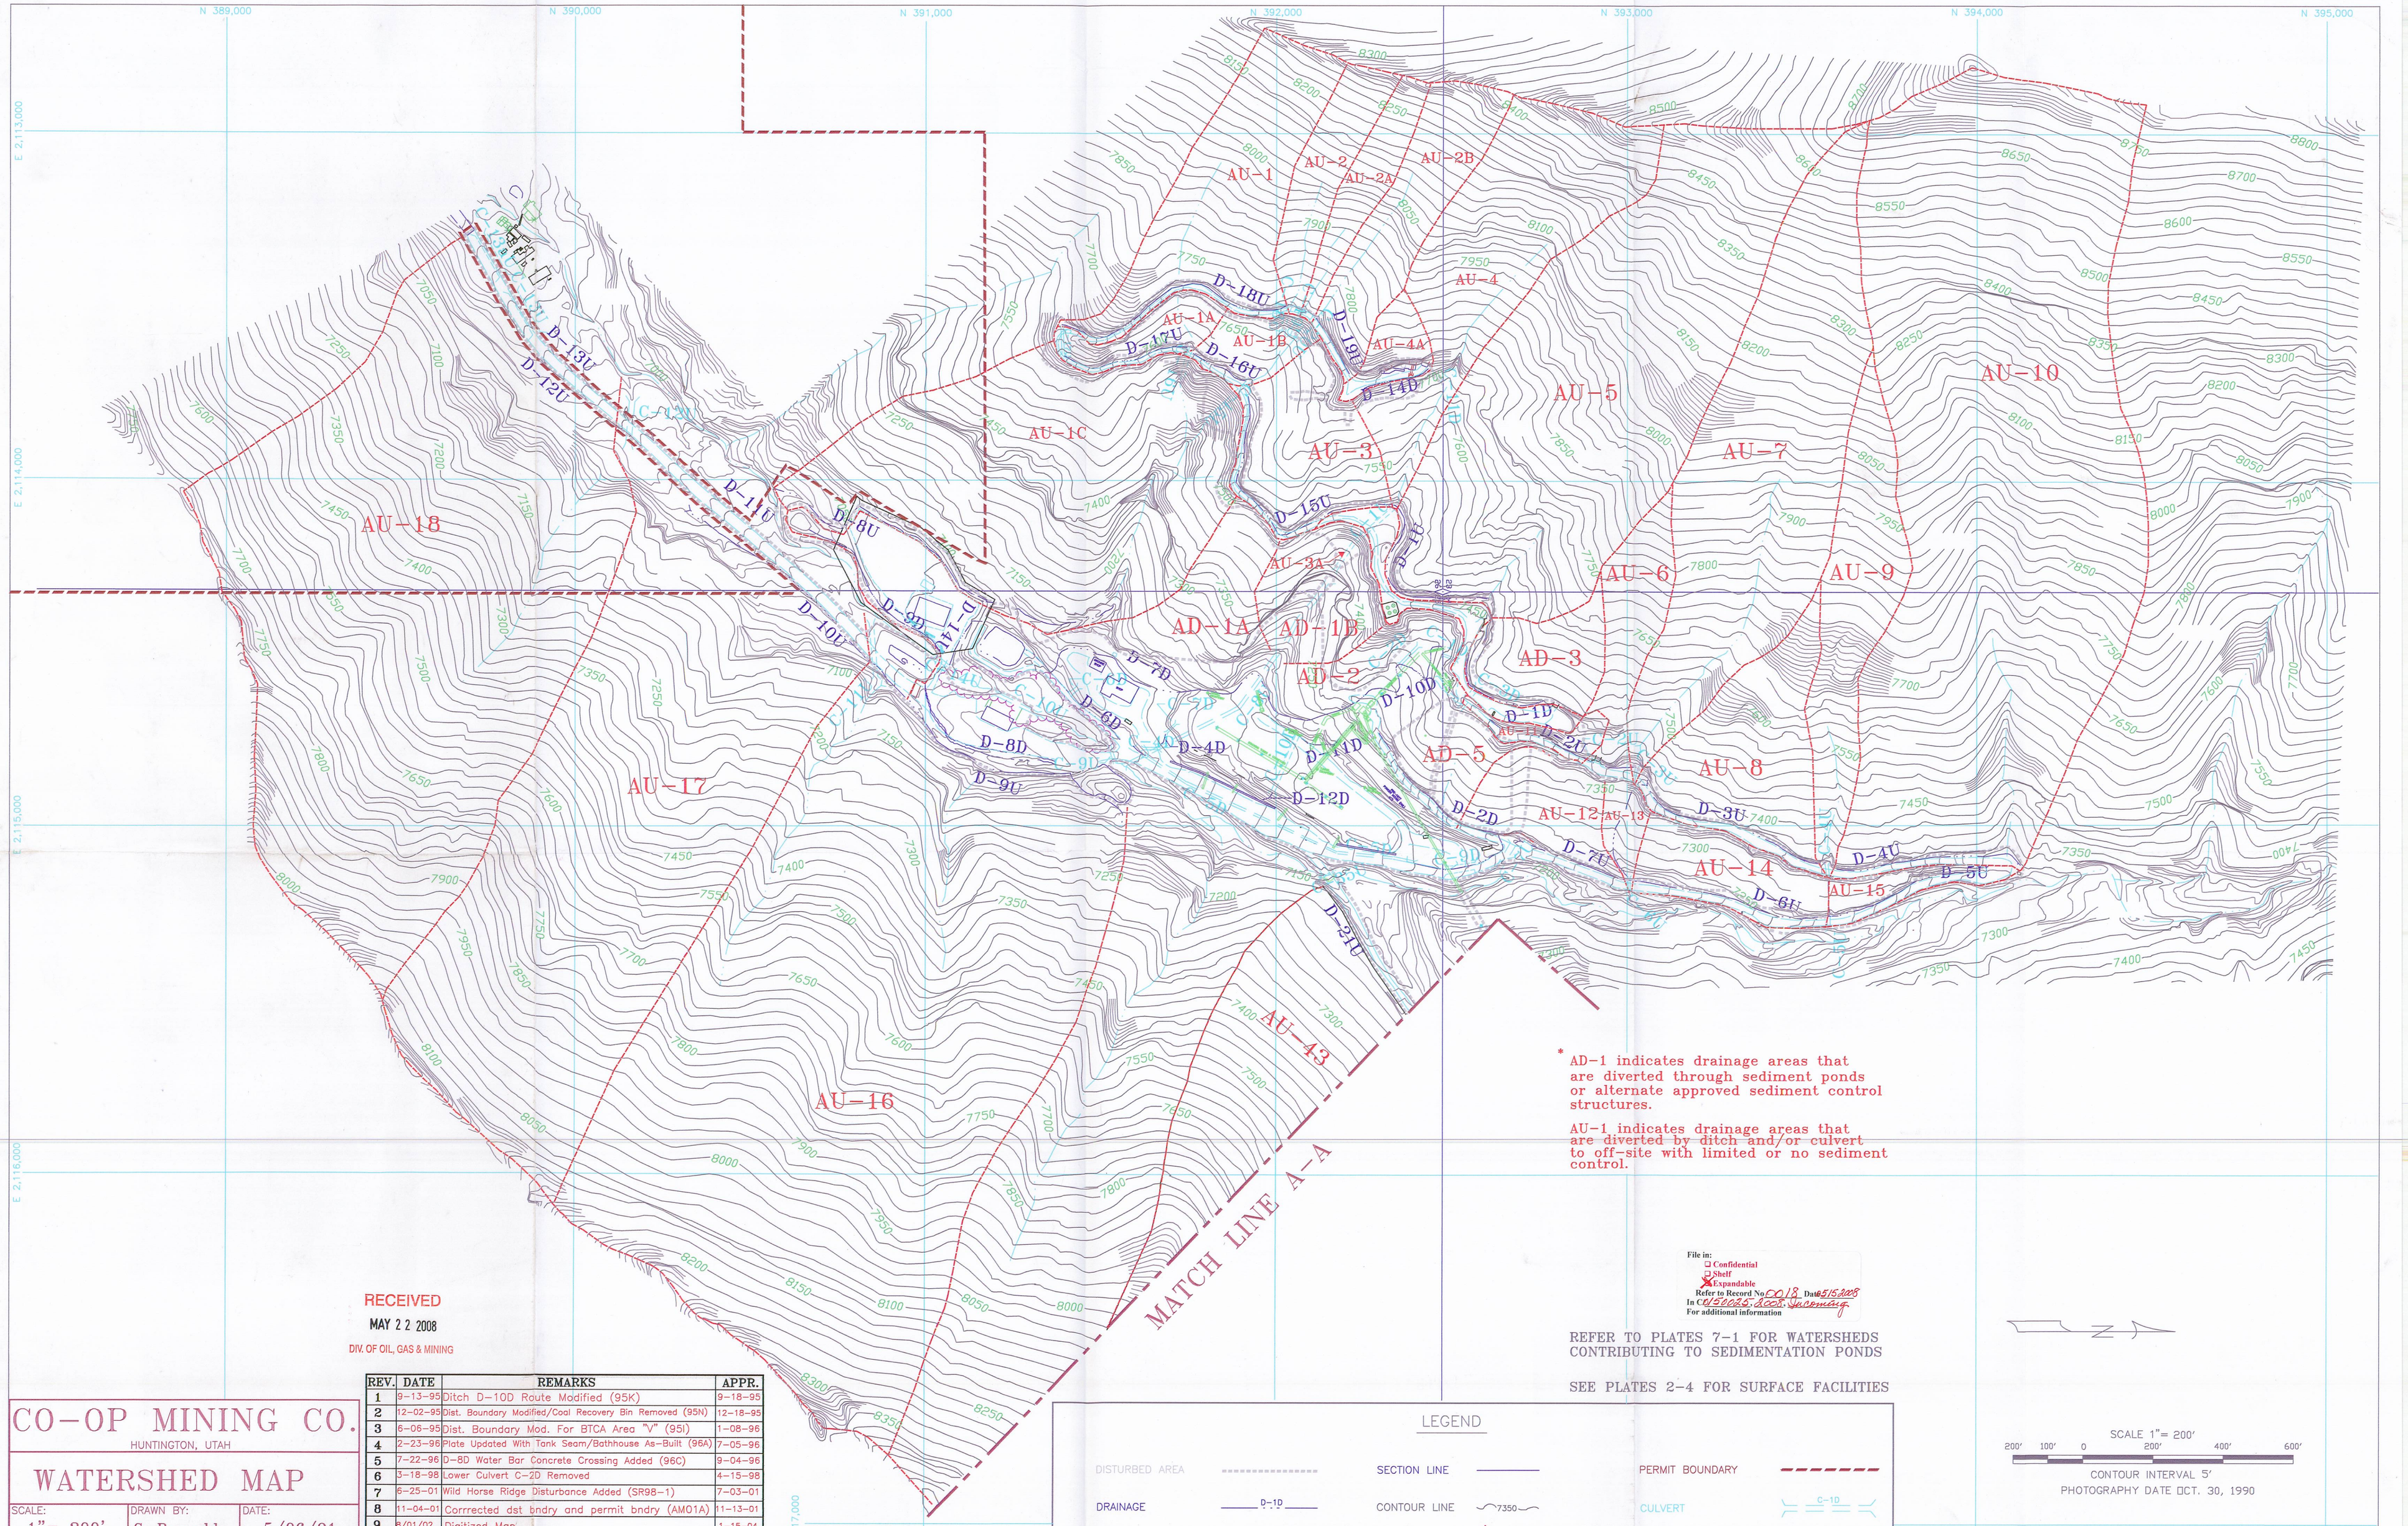

* AD-1 indicates drainage areas that are diverted through sediment ponds or alternate approved sediment control structures.

AU-1 indicates drainage areas that are diverted by ditch and/or culvert to off-site with limited or no sediment control.

RECEIVED
MAY 2 2 2008
DIV. OF OIL, GAS & MINING

File in:
☐ Confidential
☐ Shelf
☒ Expandable
Refer to Record No C0018 Date 05/15/2008
In C/150025, 2008, Incoming
For additional information

REFER TO PLATES 7-1 FOR WATERSHEDS CONTRIBUTING TO SEDIMENTATION PONDS

SEE PLATES 2-4 FOR SURFACE FACILITIES

REV.	DATE	REMARKS	APPR.
1	9-13-95	Ditch D-10D Route Modified (95K)	9-18-95
2	12-02-95	Dist. Boundary Modified/Coal Recovery Bin Removed (95N)	12-18-95
3	6-06-95	Dist. Boundary Mod. For BTCA Area "V" (95I)	1-08-96
4	2-23-96	Plate Updated With Tank Seam/Bathhouse As-Built (96A)	7-05-96
5	7-22-96	D-8D Water Bar Concrete Crossing Added (96C)	9-04-96
6	3-18-98	Lower Culvert C-2D Removed	4-15-98
7	6-25-01	Wild Horse Ridge Disturbance Added (SR98-1)	7-03-01
8	11-04-01	Corrrected dst bndry and permit bndry (AM01A)	11-13-01
9	8/01/02	Digitized Map	1-15-04
10	1/16/07	Loadout Expansion	8-07-07
11	5/09/08	Boundary change	

CO-OP MINING CO.

HUNTINGTON, UTAH

WATERSHED MAP

SCALE:	DRAWN BY:	DATE:
1"= 200'	C. Reynolds	5/06/91

BEAR CANYON | PLATE 7-5

LEGEND

DISTURBED AREA
SECTION LINE
PERMIT BOUNDARY
DRAINAGE — D-1D
CONTOUR LINE — 7350
CULVERT — C-1D
DISTURBED AREA DRAINAGE ---------- AD-1 ---------- *
UNDISTURBED AREA DRAINAGE -------- AU-1 -------- *

N

SCALE 1"= 200'
200' 100' 0 200' 400' 600'
CONTOUR INTERVAL 5'
PHOTOGRAPHY DATE OCT. 30, 1990