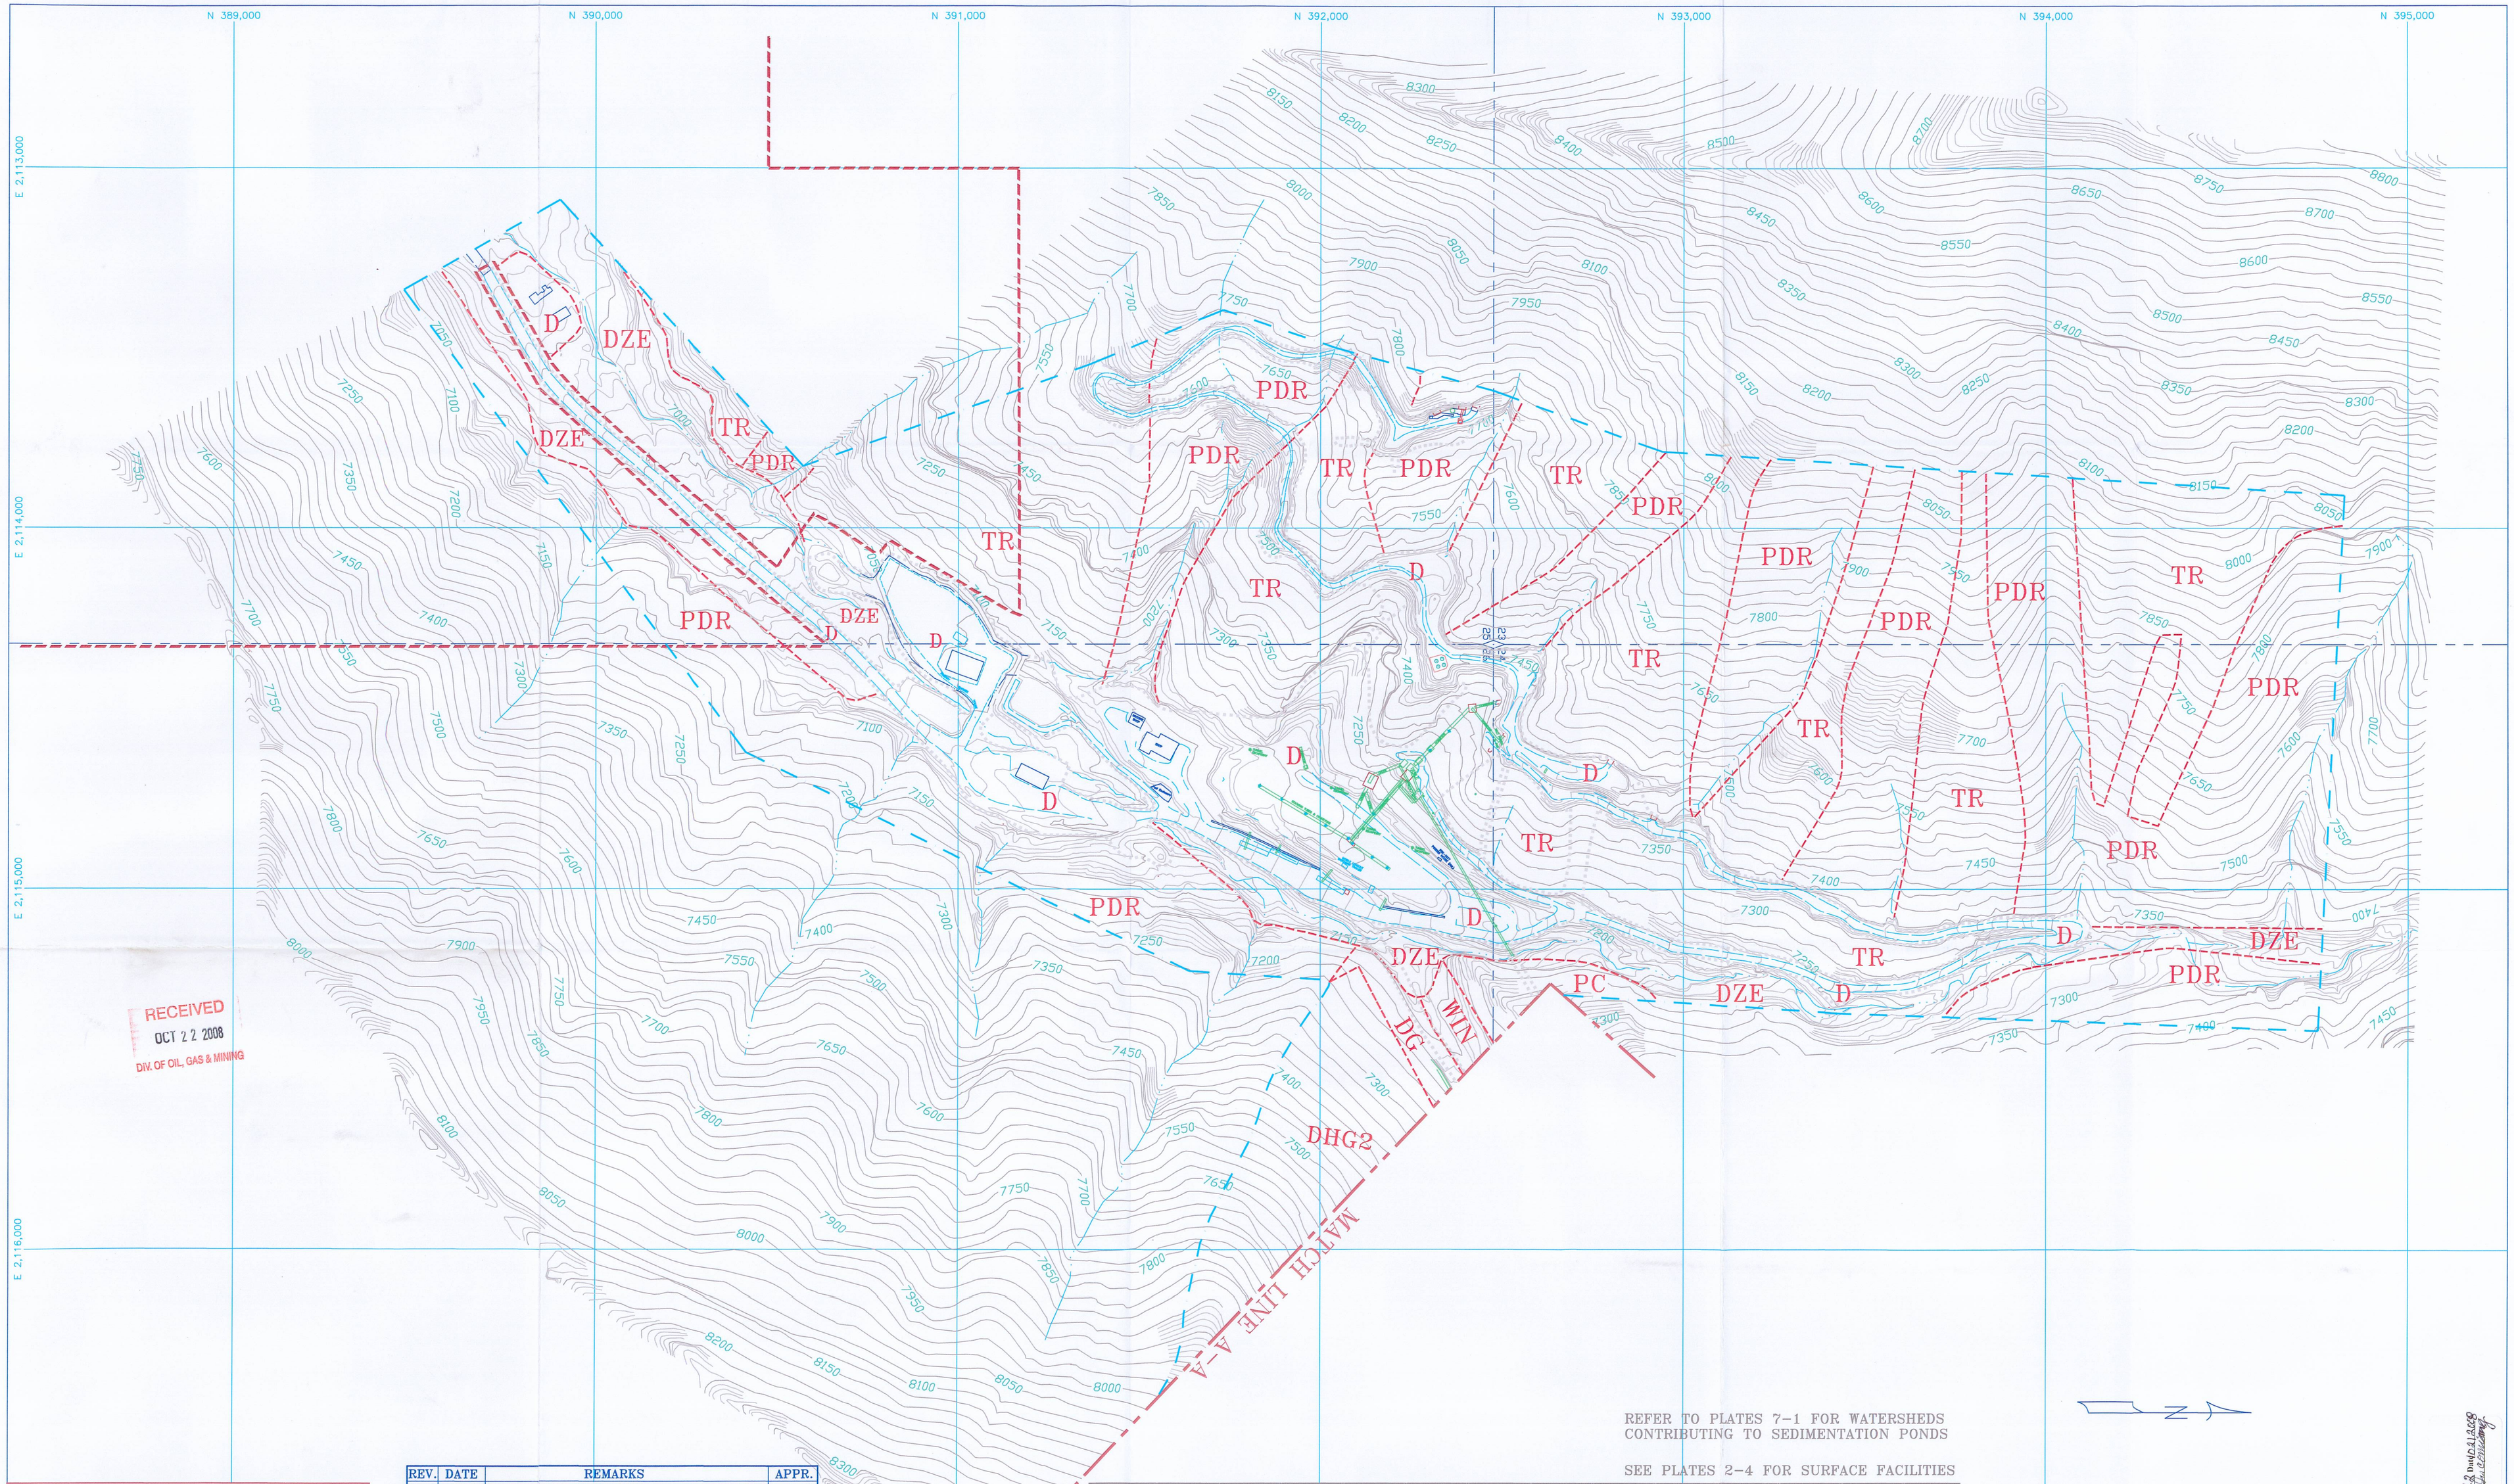

RECEIVED
OCT 22 2008
DIV. OF OIL, GAS & MINING

REFER TO PLATES 7-1 FOR WATERSHEDS CONTRIBUTING TO SEDIMENTATION PONDS

SEE PLATES 2-4 FOR SURFACE FACILITIES

SCALE 1"= 200'

200' 100' 0 200' 400' 600'

CONTOUR INTERVAL 5'
PHOTOGRAPHY DATE OCT. 30, 1990

LEGEND

DISTURBED AREA	D	SECTION LINE		PERMIT BOUNDARY	
SOIL BOUNDRY		CONTOUR LINE	7350	SURVEY BOUNDARY	
DATINO-SHEEPCAN-WINETTI	DZE	PODO-DATINO-ROCK	PDR	TRAVESSILLA	TR

REV.	DATE	REMARKS	APPR.
1	5-30-95	Tipple Structure Expansion/Rock Crusher Conveyor/Water Tank (95G)	9-12-95
2	9-13-95	Ditch D-10D Route Modified (95J)	9-18-95
3	12-02-95	Disturbed Boundary Modified/Coal Recovery Bin Removed (95N)	12-18-95
4	6-06-95	Dist. Boundary Mod. for BTCA Area "V" (95I)	1-08-96
5	2-23-96	Plate Updated for Tank Seam/Bathhouse As-built (96A)	7-05-96
6	7-22-96	D-8D Water Bar Concrete Crossing Added (96C)	9-04-96
7	3-18-98	Lower Culvert C-2D Removed	4-15-98
8	6-25-01	Wild Horse Ridge Disturbance Area Added (SR98-1)	7-03-01
9	8-01-02	Changed from plate 8-1 to 2-1A	12-08-05
10	1-16-07	Loadout Expansion	8-07-07
11	5-09-08	Boundary change	

CO-OP MINING CO.

HUNTINGTON, UTAH

SOILS MAP

SCALE:	DRAWN BY:	DATE:
1"= 200'	C. Reynolds	8/25/92

BEAR CANYON | PLATE 2-1A

FILE IN:
☐ Confidential
☐ Shelf
☒ Expandable
☐ Restricted
In C0250043 2008101 2008101
For additional information