CO-OP MINING CO.

HUNTINGTON, UTAH

SURFACE FACILITIES

SCALE:	DRAWN BY:	DATE:
1" = 50'	C. Reynolds	8/26/91

BEAR CANYON | PLATE 5-2C

REV.	DATE	REMARKS	APPR.
1	2/23/96	Plate Updated With Tank Seam As-Builts (96A)	7/05/96
2	6/23/97	Scalehouse Pavement Added (97B)	11/03/97
3	3/18/98	Lower Culvert C-2D Removed (98A)	4/15/98
4	6/18/98	Corrections For Midterm Review 1998 (98MT)	12/03/98
5	6/25/01	WHR surface facilities added (SR98-1)	7/03/01
6	11/04/01	Corrected dst bndry, removed permit bndry (AM01a)	11/13/01
7	7/08/02	Added Fan, Moved Powder House/Water Tank (AM02H)	8/14/02
8	5/10/02	Added fule containment Enclosure (AM02E)	8/15/02
9	8/01/02	Changed name from 2-4C to 5-2C	12/8/05
10	1/5/09	Showed Reclaimed Areas	

RECEIVED
FEB 17 2009
DIV. OF OIL, GAS & MINING

File in:
☐ Confidential
☐ Shelf
☒ Expandable
Refer to Record No. 0015 Date 02/12/2009
In C/015/0025, 2009, Incoming
For additional information

CROSS-SECTIONS LOCATED ON PLATE 3-1.

LEGEND
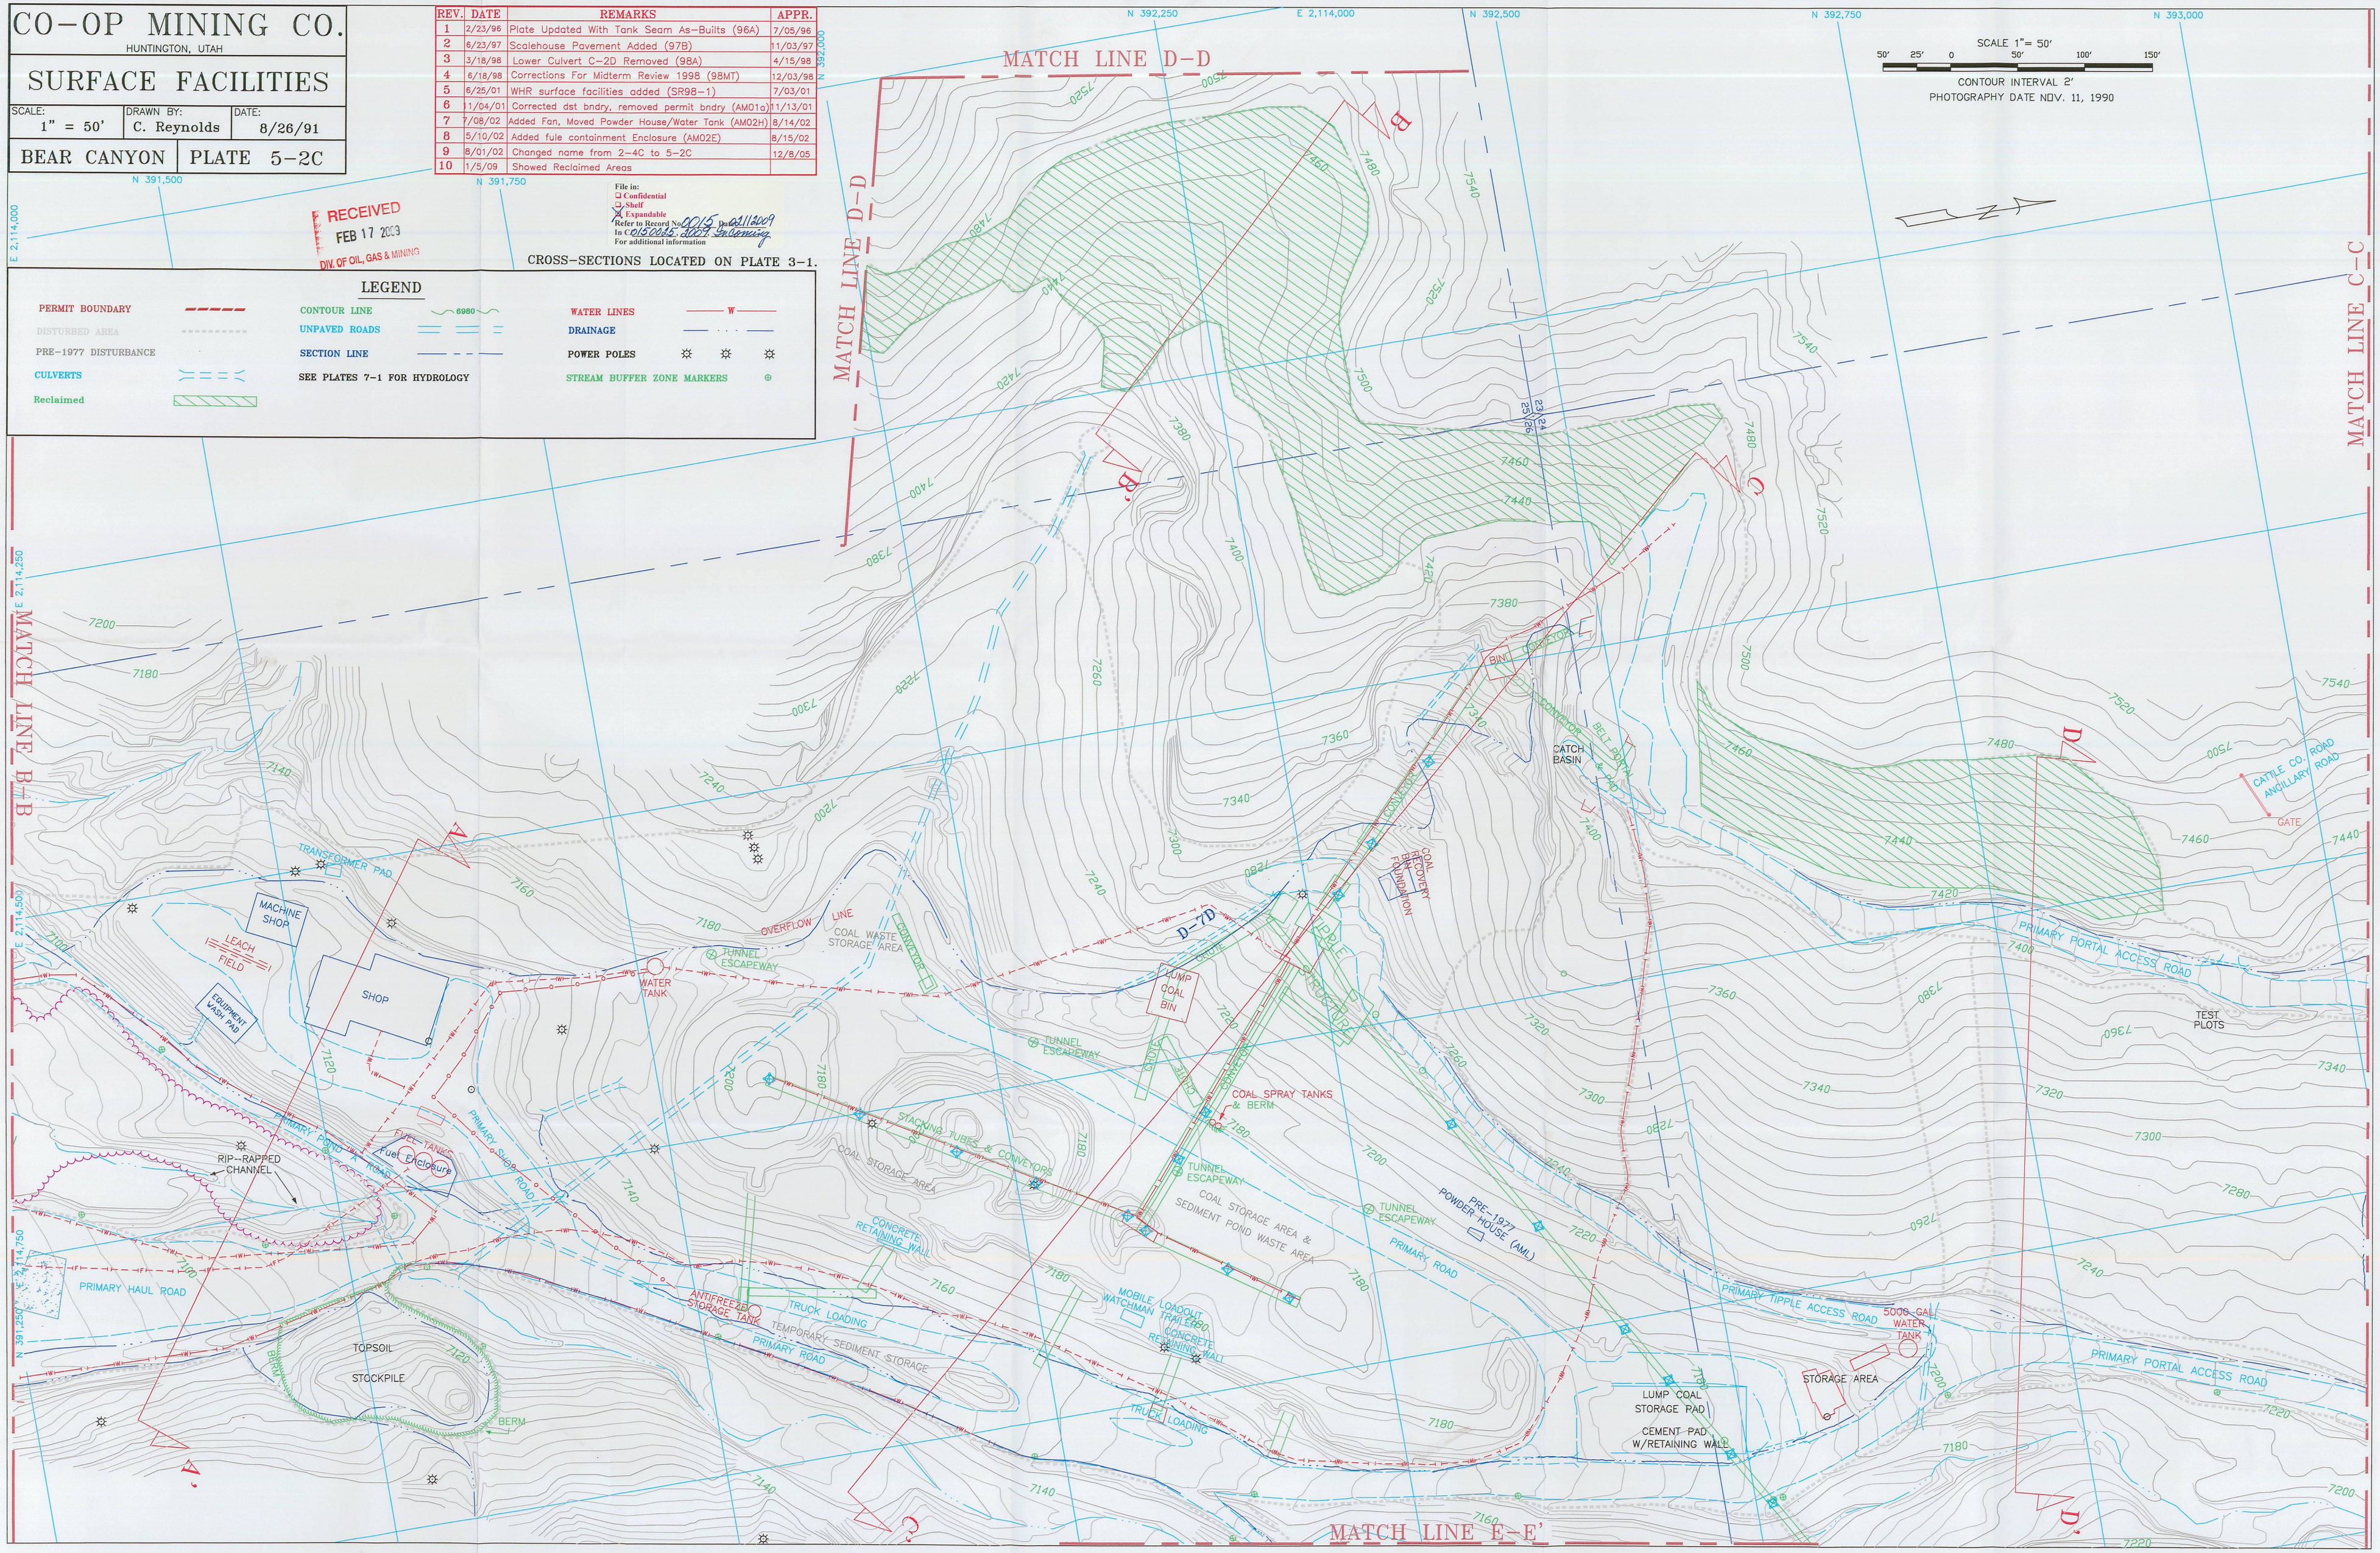
PERMIT BOUNDARY		CONTOUR LINE	6980	WATER LINES	W
DISTURBED AREA		UNPAVED ROADS		DRAINAGE	
PRE-1977 DISTURBANCE		SECTION LINE		POWER POLES	
CULVERTS		SEE PLATES 7-1 FOR HYDROLOGY		STREAM BUFFER ZONE MARKERS	
Reclaimed