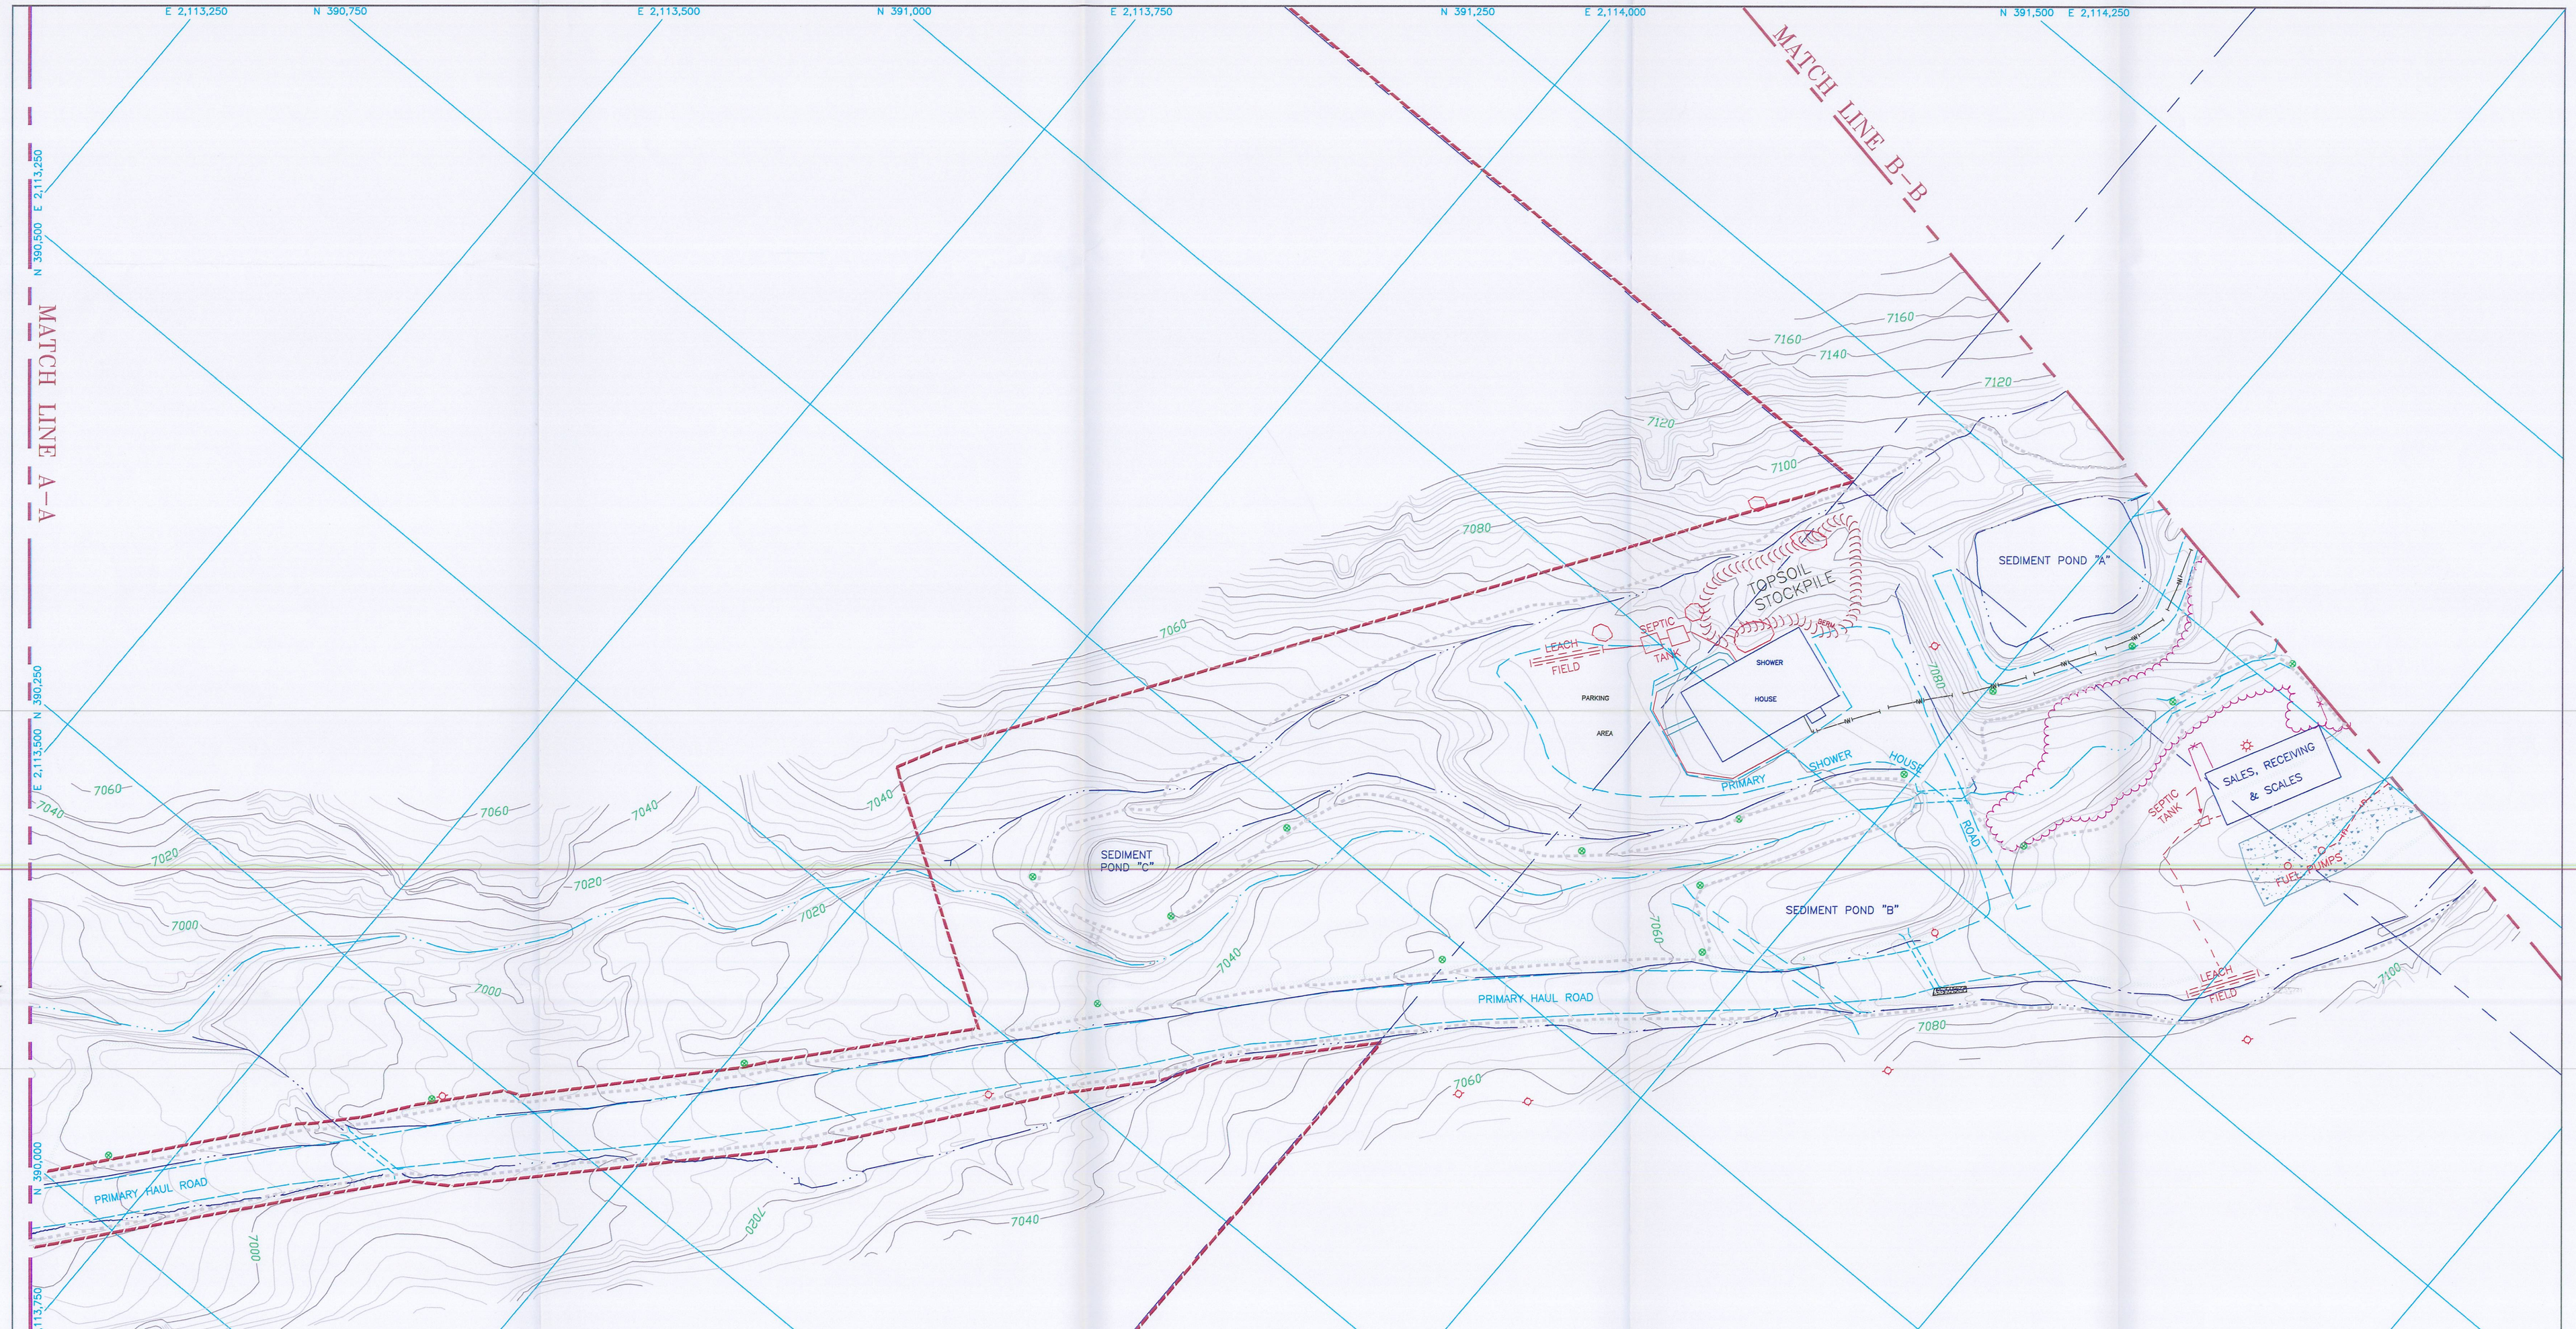

ENGINEER'S CERTIFICATION

I hereby certify that this drawing was revised by me or under my direct supervision and that all of the information presented on this drawing is true and correct to the best of my knowledge and belief.

REGISTERED ENGINEER No. 5160041-2202 JAMES E. STOVER STATE OF UTAH

James E. Stover
Utah P.E. 5160041-2202

Date 10-14-10

RECEIVED
OCT 19 2010
DIV. OF OIL, GAS & MINING

CASTLE VALLEY MINING, LLC

SURFACE FACILITIES

SCALE:	DRAWN BY:	DATE:
1" = 50'	C. Reynolds	8/26/91

BEAR CANYON | PLATE 5-2B

REV.	DATE	REMARKS	APPR.
2	4-28-92	Sediment Pond "A" Disturbed Boundary Corrected	9-18-92
3	11-20-92	Shower House Proposal Added (92H)	2-09-93
4	8-24-94	Shower House Waterline Added (94C)	10-19-94
5	2-23-96	Map Updated For Shower House Pad As-Builts (96A)	7-05-96
6	7-22-96	D-8D Water Bar Concrete Crossing Added (96C)	9-04-96
7	6-23-97	Scalehouse Pavement Added (97B)	11-03-97
8	12-30-99	Steel Bridge Structure/Contours Near Bath House (00A)	2-10-00
9	6-25-01	Permit Boundary Changed for WHR Addition (SR98-1)	7-3-01
10	8/01/02	Changed name from 2-4B to 5-2B	12-8-05
11	10/12/10	NOV 10068: Ditch D-8D concrete lining, Valve box	

LEGEND

PERMIT BOUNDARY
DISTURBED AREA
PRE-1977 DISTURBANCE
CULVERTS
CONTOUR LINE 6980
UNPAVED ROADS
SECTION LINE
SEE PLATES 7-1 FOR HYDROLOGY
PAVEMENT
WATER LINES W
DRAINAGE
POWER LINES
STREAM BUFFER ZONE MARKERS

File in:
☐ Confidential
☐ Shelf
☒ Expandable
Date Folder 10/19/2010 C1 0150025
See Incoming For additional

SCALE 1"= 50'
50' 25' 0 50' 100' 150'
CONTOUR INTERVAL 2'
PHOTOGRAPHY DATE NOV. 11, 1990