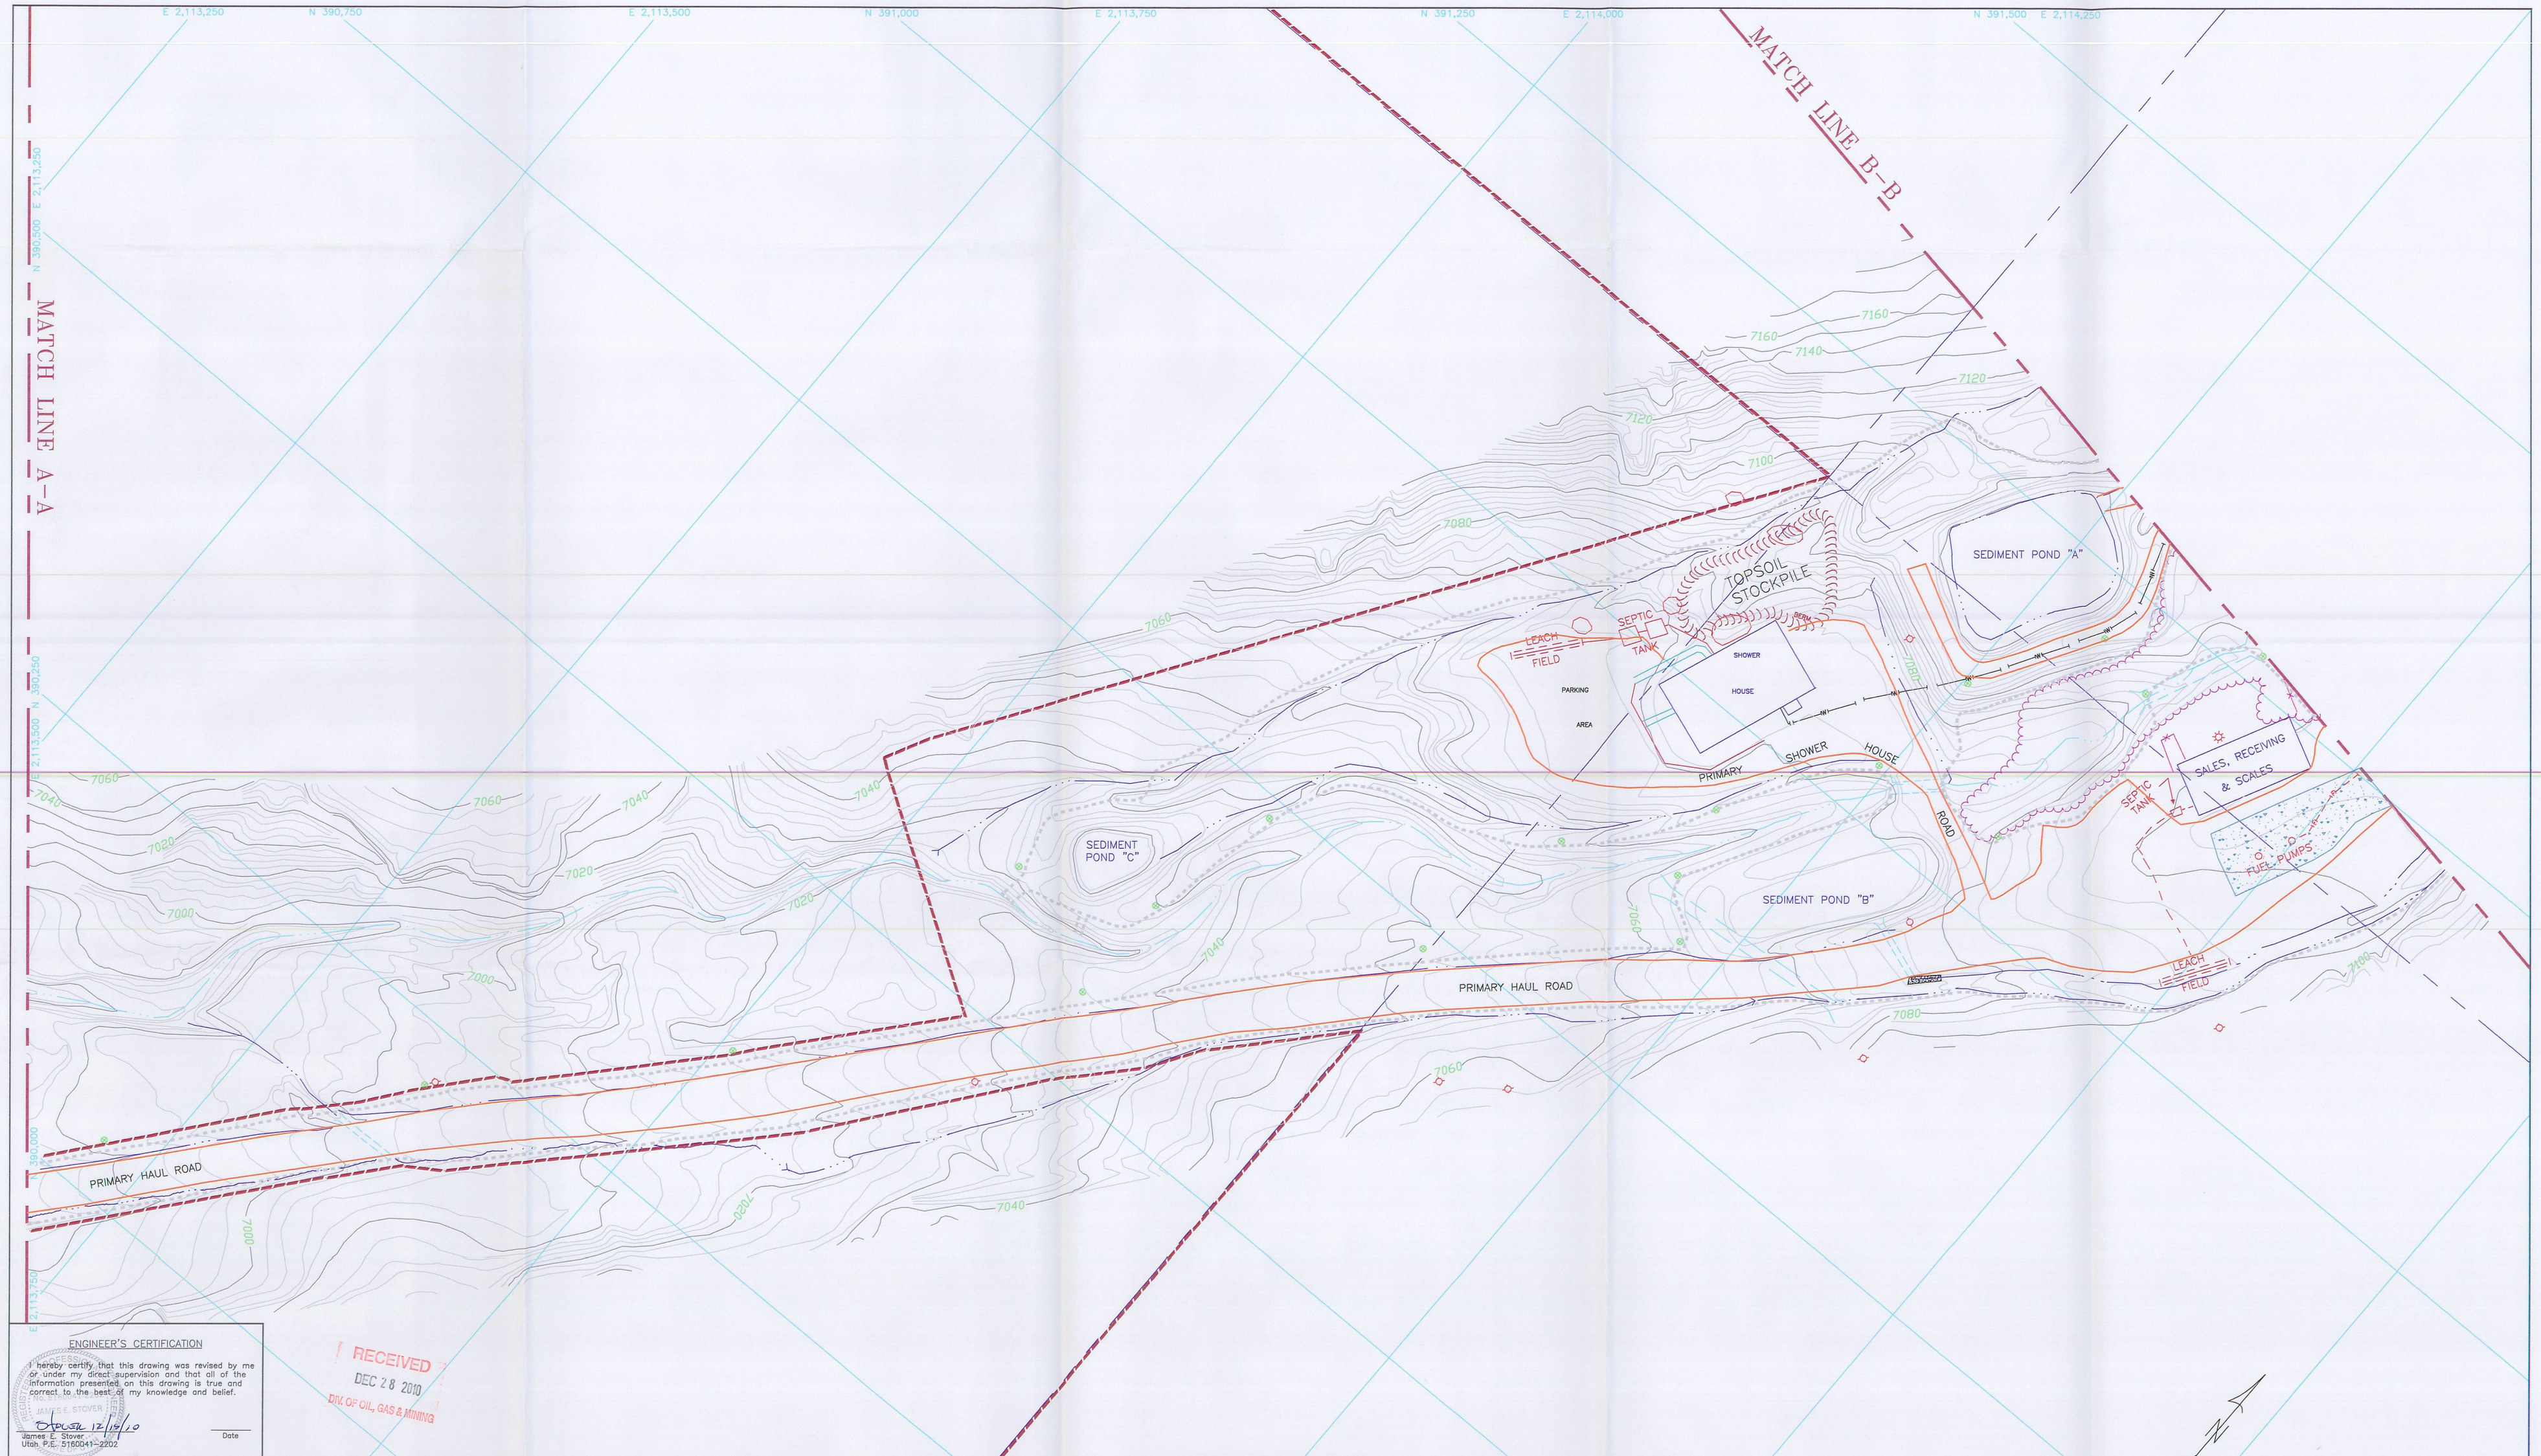

ENGINEER'S CERTIFICATION

I hereby certify that this drawing was revised by me or under my direct supervision and that all of the information presented on this drawing is true and correct to the best of my knowledge and belief.

REGISTERED PROFESSIONAL ENGINEER
JAMES E. STOVER
Utah 5160041-2202

James E. Stover
Utah P.E. 5160041-2202

Date

RECEIVED
DEC 28 2010
DIV. OF OIL, GAS & MINING

CASTLE VALLEY MINING, LLC

SURFACE FACILITIES

SCALE:	DRAWN BY:	DATE:
1" = 50'	C. Reynolds	8/26/91

BEAR CANYON | PLATE 5-2B

REV.	DATE	REMARKS	APPR.
2	4-28-92	Sediment Pond "A" Disturbed Boundary Corrected	9-18-92
3	11-20-92	Shower House Proposal Added (92H)	2-09-93
4	8-24-94	Shower House Waterline Added (94C)	10-19-94
5	2-23-96	Map Updated For Shower House Pad As-Builts (96A)	7-05-96
6	7-22-96	D-8D Water Bar Concrete Crossing Added (96C)	9-04-96
7	6-23-97	Scalehouse Pavement Added (97B)	11-03-97
8	12-30-99	Steel Bridge Structure/Contours Near Bath House (00A)	2-10-00
9	6-25-01	Permit Boundary Changed for WHR Addition (SR98-1)	7-3-01
10	8/01/02	Changed name from 2-4B to 5-2B	12-8-05
11	12/14/10	NOV 10068:Ditch D-8D concrete lining, Valve box, haul road color	

LEGEND

PERMIT BOUNDARY		CONTOUR LINE	6980	PAVEMENT	
DISTURBED AREA		UNPAVED ROADS		WATER LINES	W
PRE-1977 DISTURBANCE		SECTION LINE		DRAINAGE	
CULVERTS		SEE PLATES 7-1 FOR HYDROLOGY		POWER LINES	
				STREAM BUFFER ZONE MARKERS	

File in:
☐ Confidential
☐ Shelf
☒ Expandable
In C/0150025 Incoming
Date: 12/28/2010 For additional information

SCALE 1"= 50'
50' 25' 0 50' 100' 150'
CONTOUR INTERVAL 2'
PHOTOGRAPHY DATE NOV. 11, 1990