RECEIVED
SEP 26 2013
DIV. OF OIL, GAS & MINING

File in:
☐ Confidential
☒ Shelf
☐ Expandable
Date Folder: 09262013-0150025
Incoming

CASTLE VALLEY MINING, LLC

HUNTINGTON, UTAH

RECLAMATION AREA

SCALE:	DRAWN BY:	DATE:
1"= 50'	C. REYNOLDS	5/13/91

PLATE 2-3C

REV.	DATE	REMARKS	APPR.
1	10/22/93	Tank Seam Road, TS-10 Added (93B)	7/22/94
2	8/01/94	Lamphouses Removed/Portal Pad Recontoured	8/17/94
3	5/30/95	Tipple Structure Expansion/Rock Crusher Conveyor (95G)	9/12/95
4	9/13/95	Ditch D-10D Route Modification (95K)	9/18/95
5	12/02/95	Dist. Boundary Modified/Coal Recovery Bin Removed (95N)	12/18/95
6	2/23/96	Plate Updated With Tank Seam As-Builts	7/05/96
7	5/31/98	Wild Horse Ridge Disturbance Added	6/25/01
8	10/13/01	Added TS-4, TS-5 boundary and cross-sections, moved road (01A) Corrected Disturbed Boundary and Reclamation Boundary.	11/13/01
9	8/01/02	Changed name from 8-5C to 2-3C	12/8/05
10	1/16/07	Loadout Expansion	8/07/07

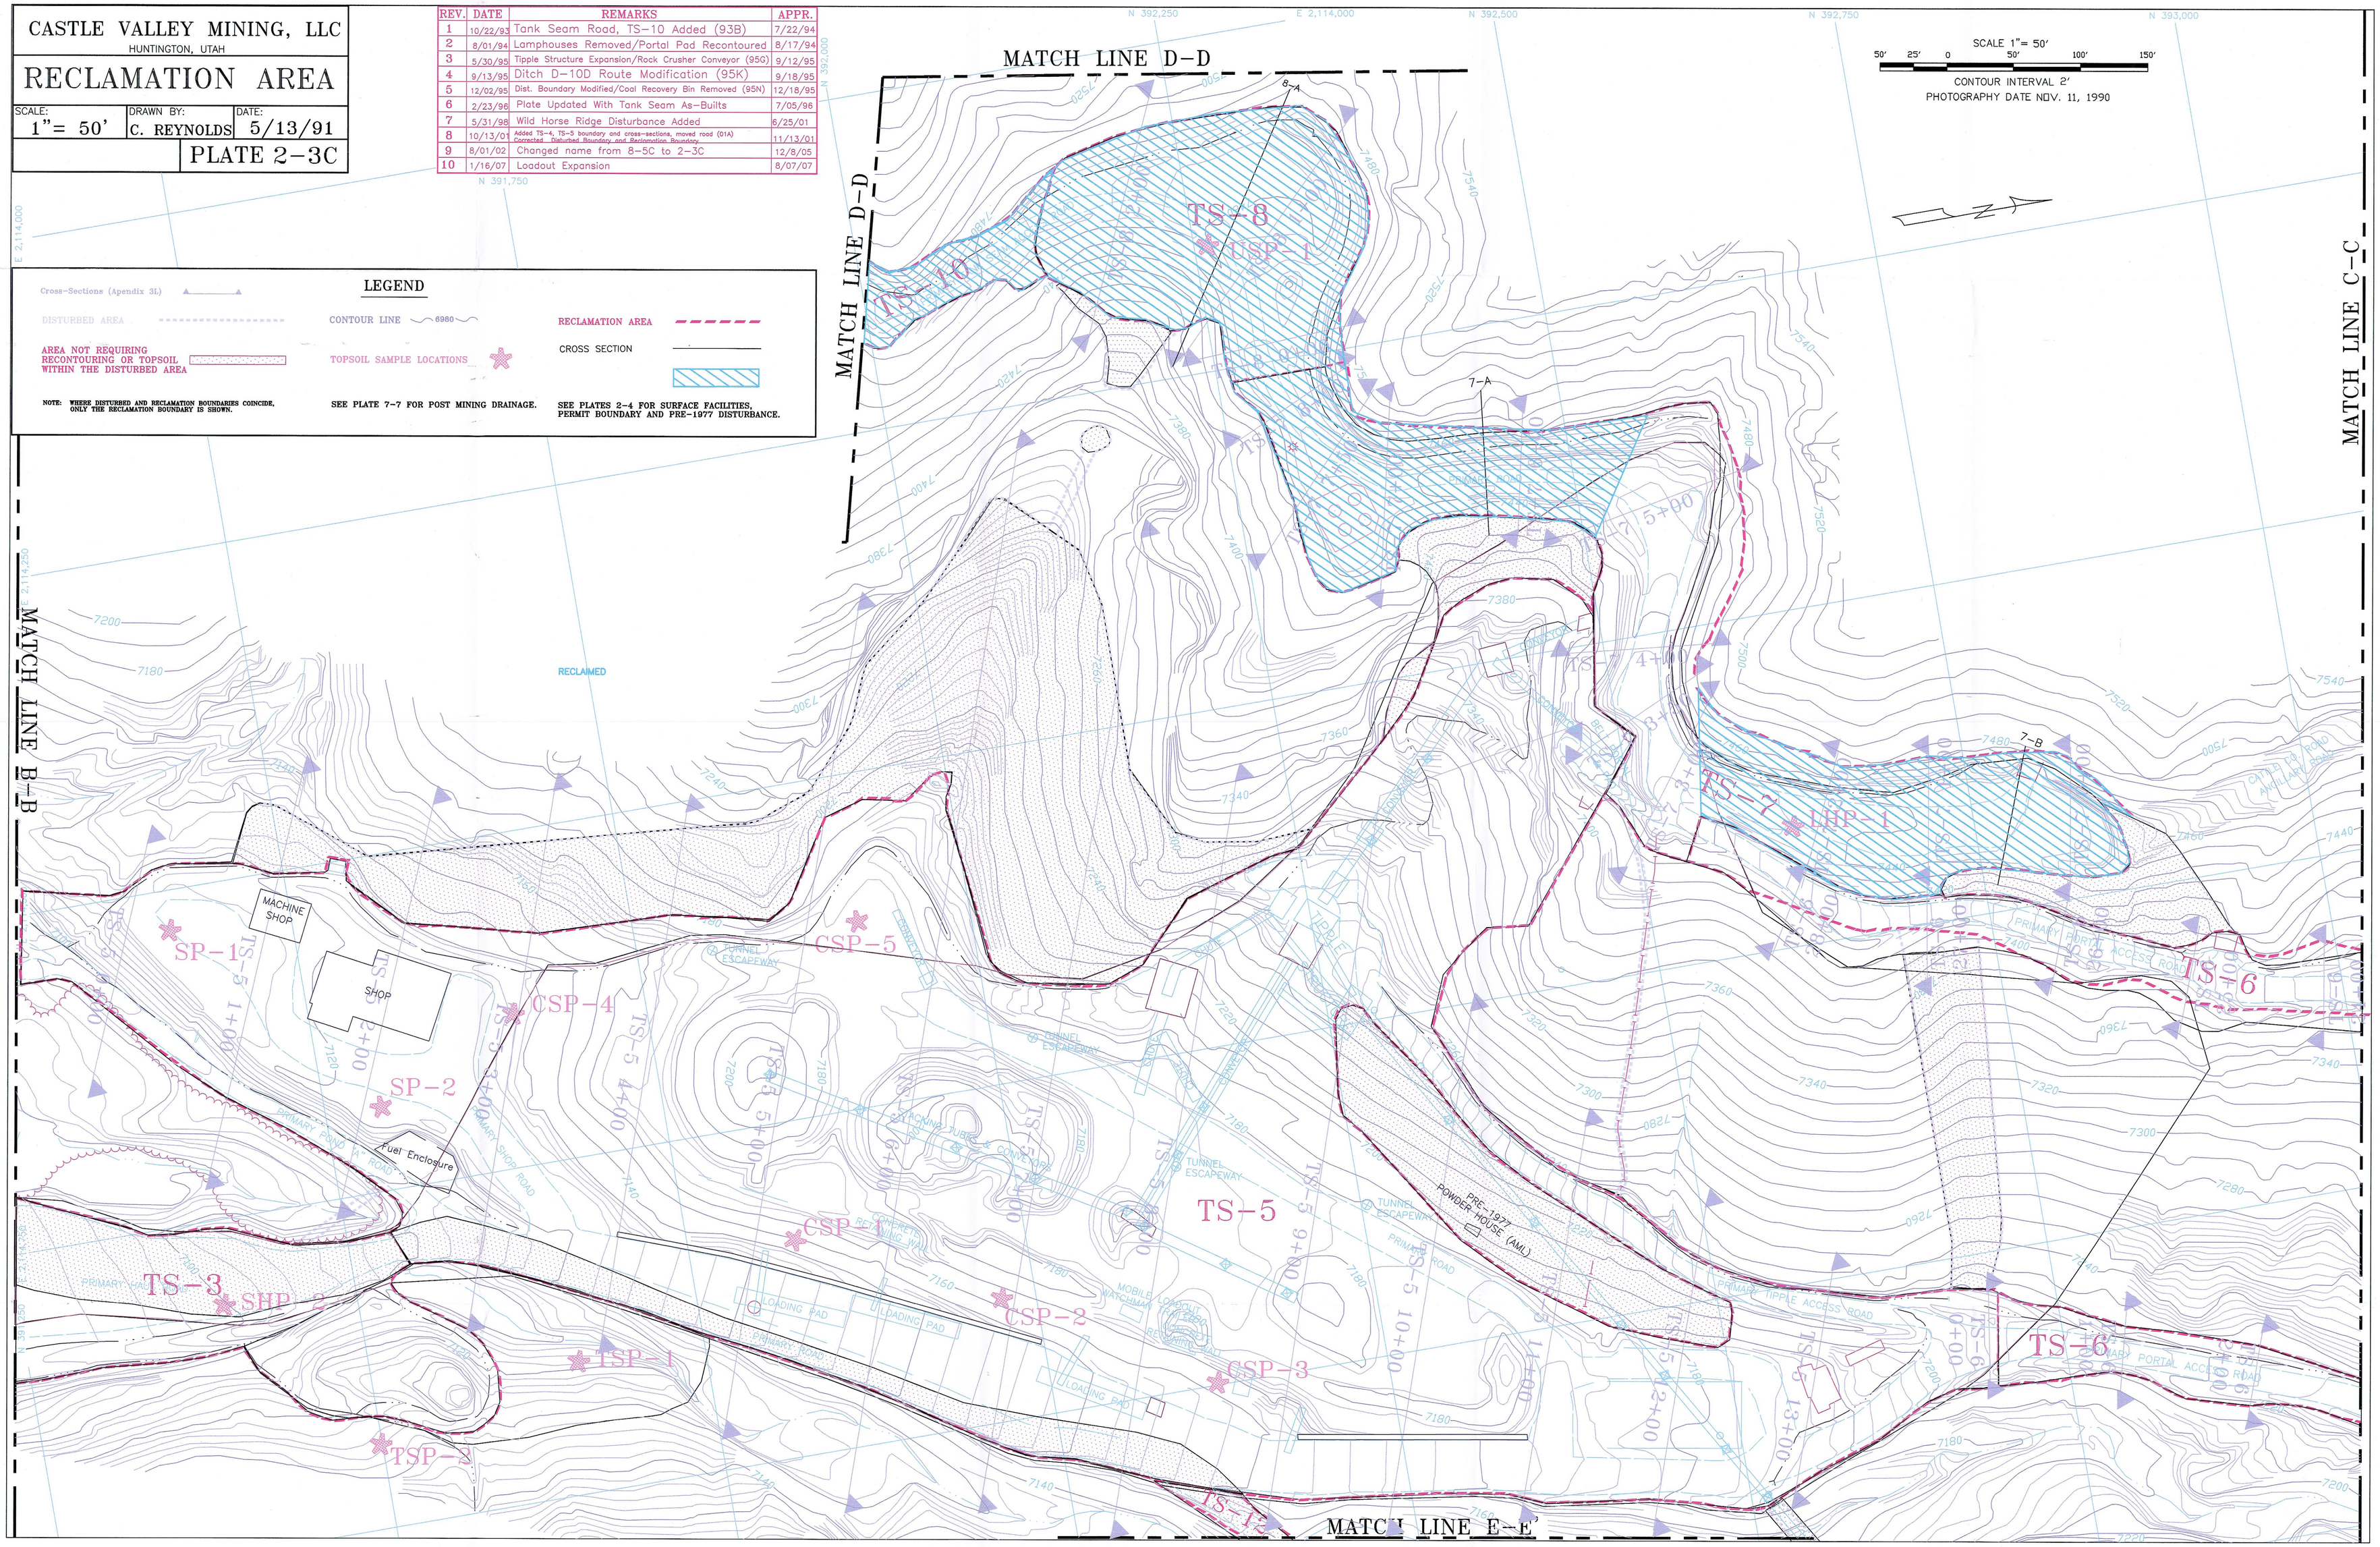

LEGEND

Cross-Sections (Apendix 3L)

DISTURBED AREA

CONTOUR LINE 6980

RECLAMATION AREA

AREA NOT REQUIRING RECONTOURING OR TOPSOIL WITHIN THE DISTURBED AREA

TOPSOIL SAMPLE LOCATIONS

CROSS SECTION

NOTE: WHERE DISTURBED AND RECLAMATION BOUNDARIES COINCIDE, ONLY THE RECLAMATION BOUNDARY IS SHOWN.

SEE PLATE 7-7 FOR POST MINING DRAINAGE.

SEE PLATES 2-4 FOR SURFACE FACILITIES, PERMIT BOUNDARY AND PRE-1977 DISTURBANCE.