CASTEL VALLEY MINING, LLC
HUNTINGTON, UTAH

HYDROLOGY MAP

SCALE:	DRAWN BY:	DATE:
1" = 50'	C. Reynolds	7/17/91

PLATE 7-1C

RECEIVED
SEP 2 6 2013
DIV. OF OIL, GAS & MINING

1	1/05/95	BTCA Area "E" Silt Fence Relocated (95A)	1/26/94
2	5/30/95	Tipple Structure Expansion/Rock Crusher Conveyor (95G)	9/12/95
3	9/13/95	Ditch D-10D Route Modification (95K)	9/18/95
4	12/02/95	Fuel Line Added/Coal Recovery Bin Removed (95N)	12/18/95
5	2/23/96	Plate Updated With Tank Seam As-Builts (96A)	7/05/96
6	3/18/98	Lower Culvert C-2D Removed (98A)	4/15/98
7	12/30/99	1 Silt Fence / BTCA H Hatch Removed (AM00A)	2/10/00
8	6/25/01	Wild Horse Ridge Hydrology Added (SR98-1)	7/03/01
9	11/04/01	Corrected dst bndry, Removed Prmt bndry (AM01a)	11/13/01
10	8/01/02	Digitized Map	12/08/05
11			

File in:
☐ Confidential
☒ Shelf
☐ Expandable
Date Folder: 20130920150045
Incoming

LEGEND

PERMIT BOUNDARY	CONTOUR LINE 6900	UNDISTURBED DRAINAGE	D-2U
DISTURBED AREA	WATER LINES W	DISTURBED DRAINAGE	D-2D
PRE-1977 DISTURBANCE	SECTION LINE	DRAINAGE BOUNDARY	
CULVERTS	SEE PLATES 2-4 FOR SURFACE FACILITIES	RECLAIMED	SEE PLATE 7-5 FOR COMPLETE WATERSHED MAP
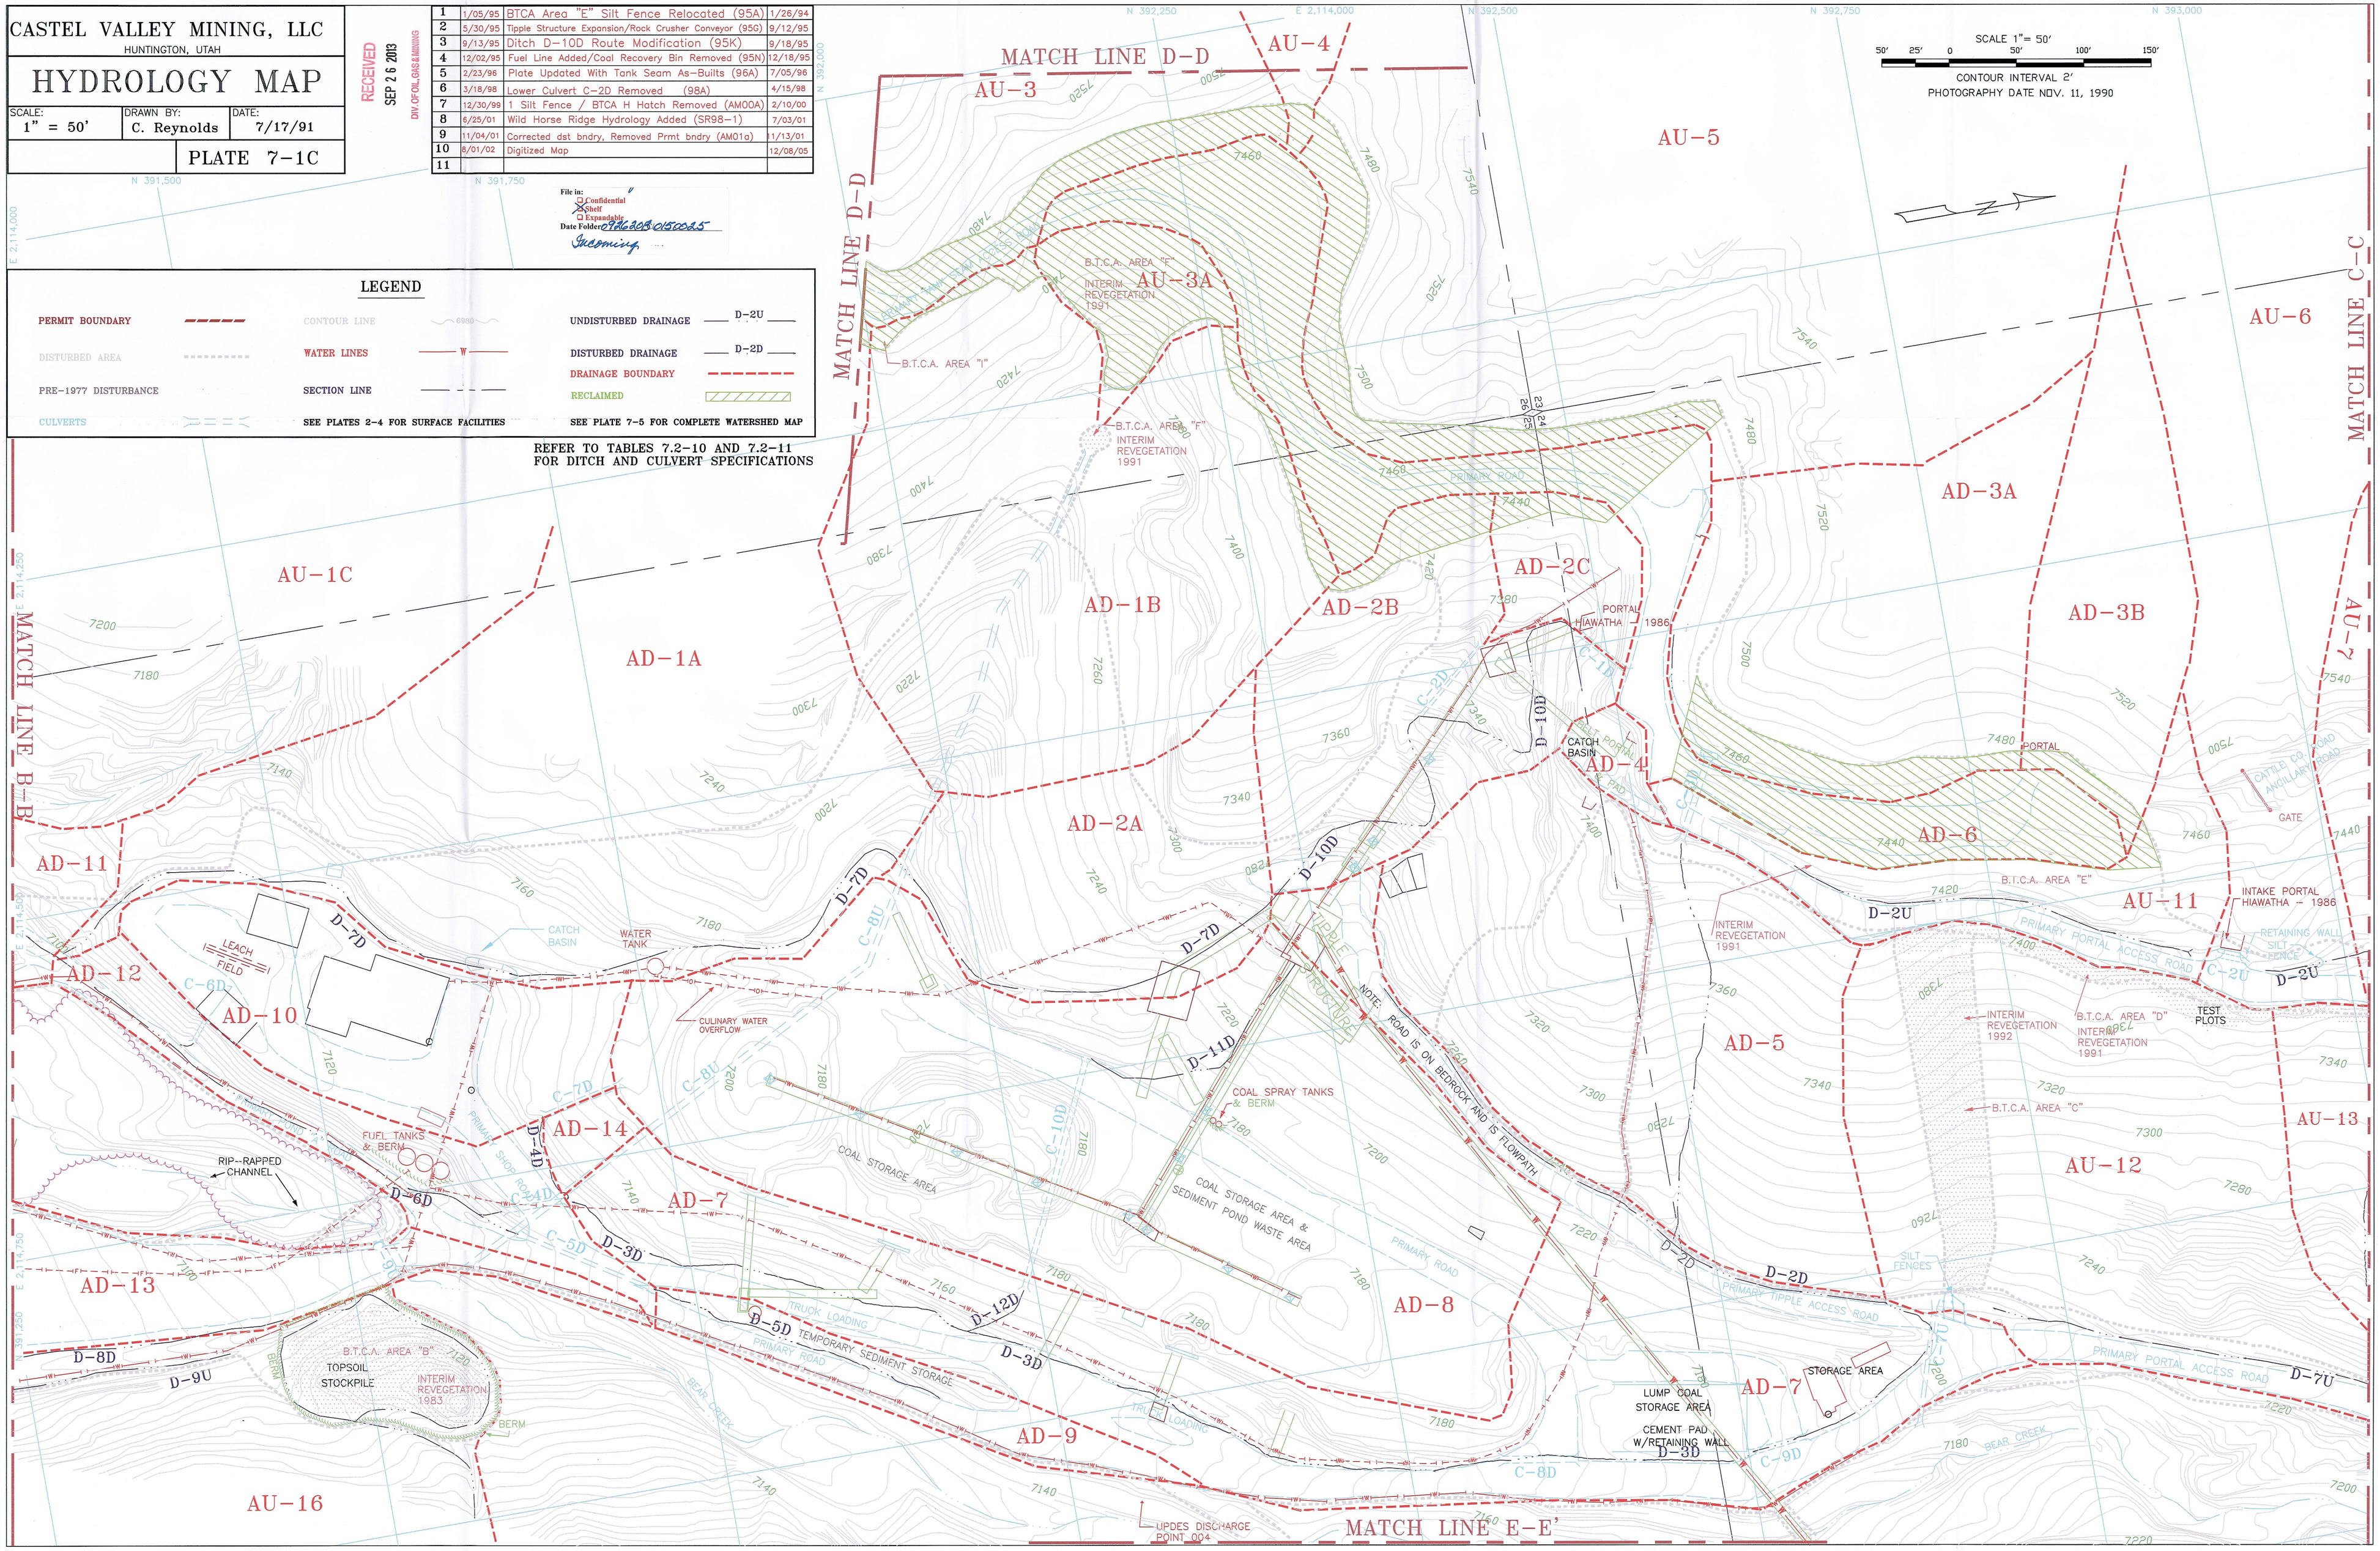
REFER TO TABLES 7.2-10 AND 7.2-11
FOR DITCH AND CULVERT SPECIFICATIONS