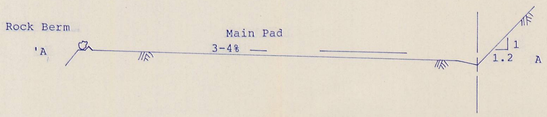

SECTION AA'
Scale 1"= 20'

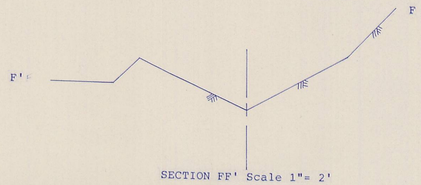

SECTION FF' Scale 1"= 2'

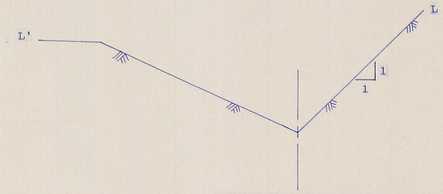

SECTION LL' Scale 1"= 2'

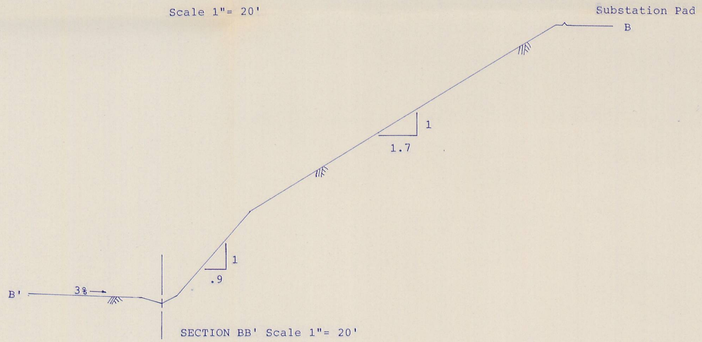

SECTION BB' Scale 1"= 20'

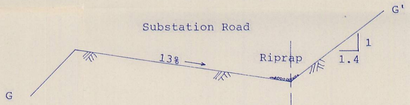

SECTION GG' Scale 1"= 4'

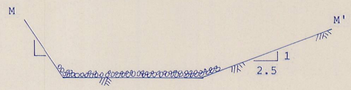

SECTION MM' Scale 1"= 4'

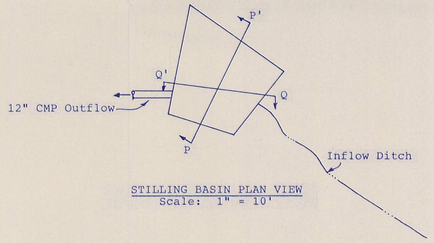

STILLING BASIN PLAN VIEW
Scale: 1" = 10'

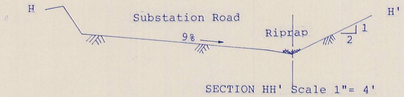

SECTION HH' Scale 1"= 4'

SECTION NN' Scale 1"= 2'

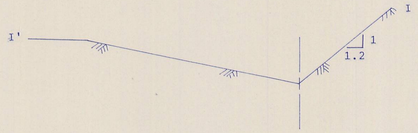

SECTION II'Scale 1"= 2'

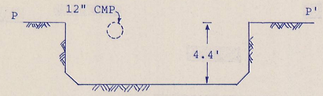

SECTION PP' Scale 1" = 5'

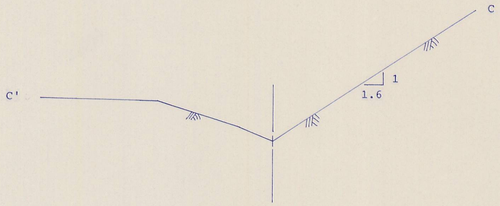

SECTION CC' Scale 1"= 2'

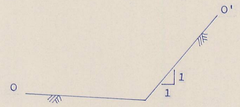

SECTION OO' Scale 1"= 4'

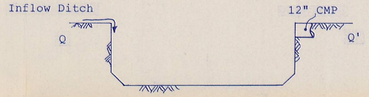

SECTION QQ' Scale 1" = 5'

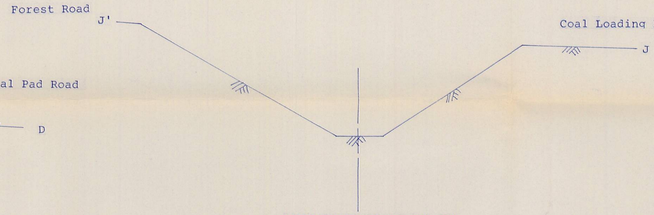

SECTION JJ' Scale 1"= 2'

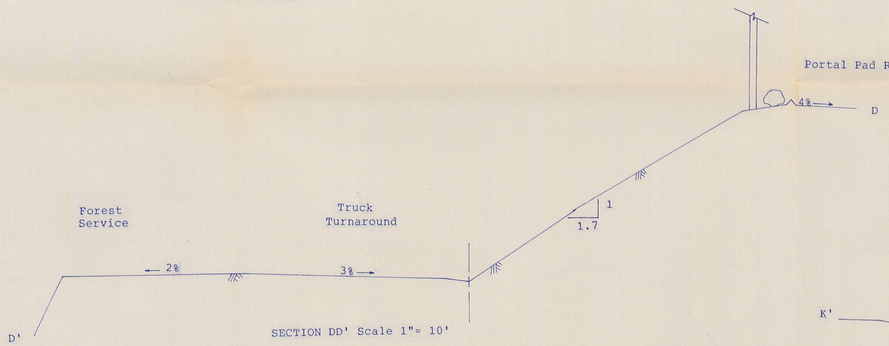

SECTION DD' Scale 1"= 10'

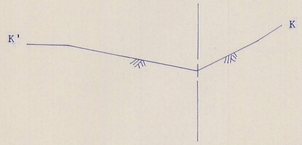

SECTION KK' Scale 1"= 2'

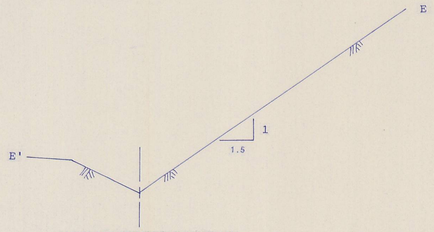

SECTION EE' Scale 1"= 2'

31 Dec 1986
No. 7102
Richard B. White

GENWAL COAL COMPANY

CROSS SECTIONS (AS BUILT)

FEB. 10, 1988 ACK

SCALE AS NOTED

PLATE 7-5b