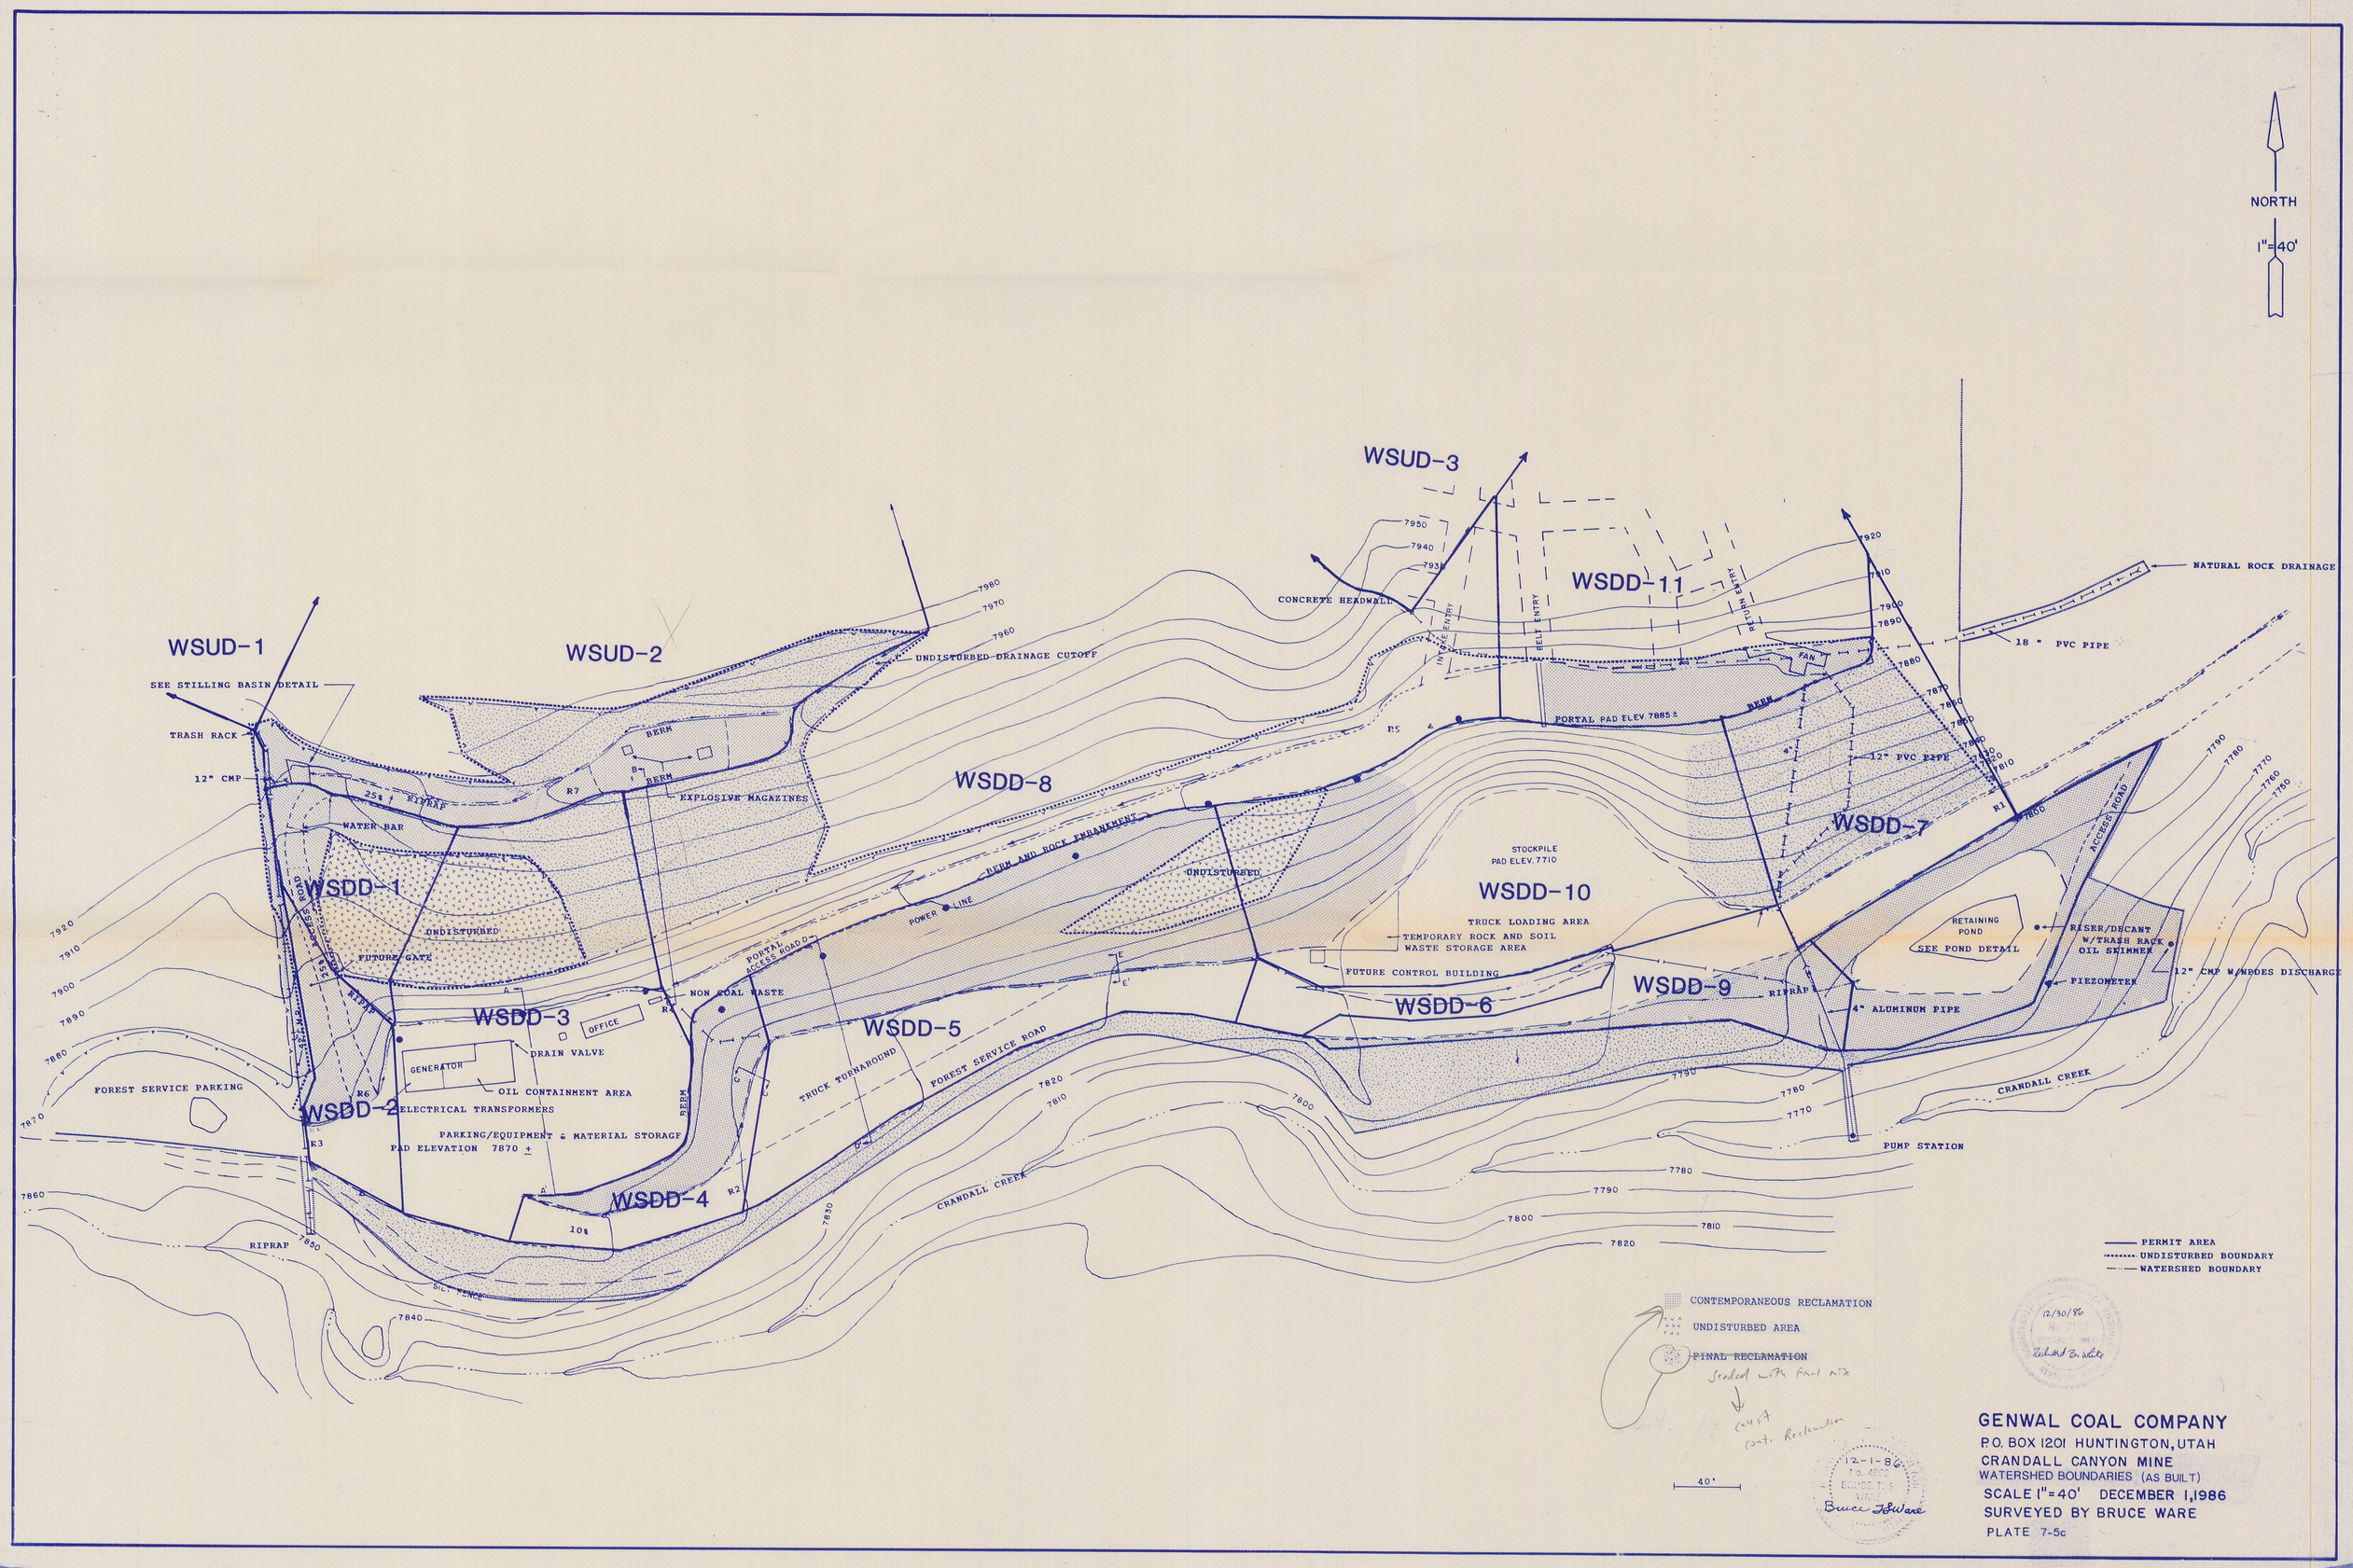
NORTH
1"=40'
WSUD-1
WSUD-2
WSUD-3
WSDD-1
WSDD-2
WSDD-3
WSDD-4
WSDD-5
WSDD-6
WSDD-7
WSDD-8
WSDD-9
WSDD-10
WSDD-11
SEE STILLING BASIN DETAIL
TRASH RACK
12" CMP
WATER BAR
RIPRAP
UNDISTURBED
FUTURE GATE
EXPLOSIVE MAGAZINES
BERM
UNDISTURBED DRAINAGE CUTOFF
CONCRETE HEADWALL
INTAKE ENTRY
BELT ENTRY
RETURN ENTRY
FAN
PORTAL PAD ELEV. 7885±
NATURAL ROCK DRAINAGE
18" PVC PIPE
12" PVC PIPE
BERM AND ROCK EMBANKMENT
POWER LINE
PORTAL ACCESS ROAD
NON COAL WASTE
OFFICE
DRAIN VALVE
GENERATOR
OIL CONTAINMENT AREA
ELECTRICAL TRANSFORMERS
PARKING/EQUIPMENT & MATERIAL STORAGE
PAD ELEVATION 7870 ±
FOREST SERVICE PARKING
TRUCK TURNAROUND
FOREST SERVICE ROAD
CRANDALL CREEK
STOCKPILE
PAD ELEV. 7710
TRUCK LOADING AREA
TEMPORARY ROCK AND SOIL
WASTE STORAGE AREA
FUTURE CONTROL BUILDING
RETAINING POND
SEE POND DETAIL
RISER/DECANT
W/TRASH RACK
OIL SKIMMER
PIEZOMETER
12" CMP W/NPDES DISCHARGE
4" ALUMINUM PIPE
PUMP STATION
ACCESS ROAD
SILT FENCE
PERMIT AREA
UNDISTURBED BOUNDARY
WATERSHED BOUNDARY
CONTEMPORANEOUS RECLAMATION
UNDISTURBED AREA
~~FINAL RECLAMATION~~
Seeded with Final mix
Const. Reclamation
40'
12/30/86
Richard B. White
12-1-86
Bruce T. Ware
GENWAL COAL COMPANY
P.O. BOX 1201 HUNTINGTON, UTAH
CRANDALL CANYON MINE
WATERSHED BOUNDARIES (AS BUILT)
SCALE 1"=40' DECEMBER 1,1986
SURVEYED BY BRUCE WARE
PLATE 7-5c