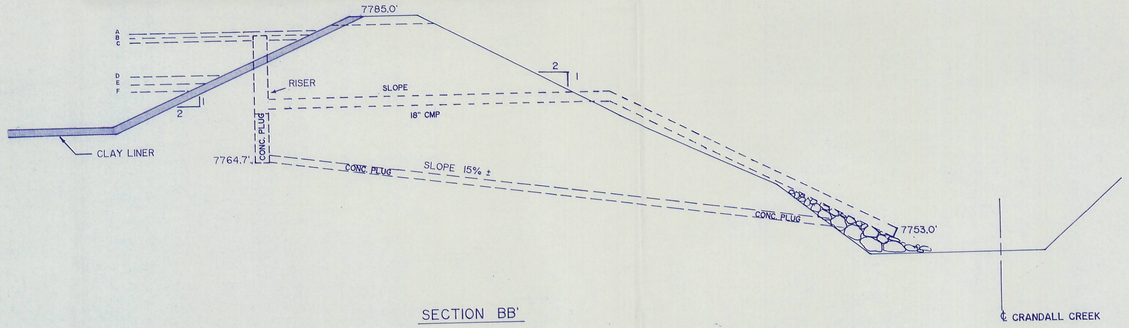

SECTION BB'

ELEVATIONS

A 25 YR. 24 HR. PEAK EL. 7783.0'
B RISER EL. 7782.5'
C 10 YR. 24 HR. STORAGE EL. 7781.9'
D DECANT OVERFLOW EL. 7776.9'
E SEDIMENT STORAGE LEVEL EL. 7775.9'
F CLEANOUT EL. 7774.9'

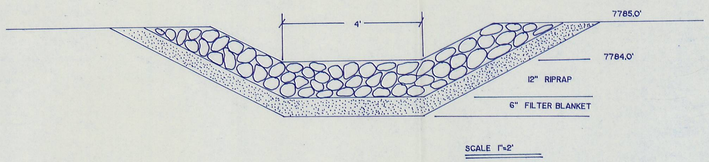

SECTION DD'

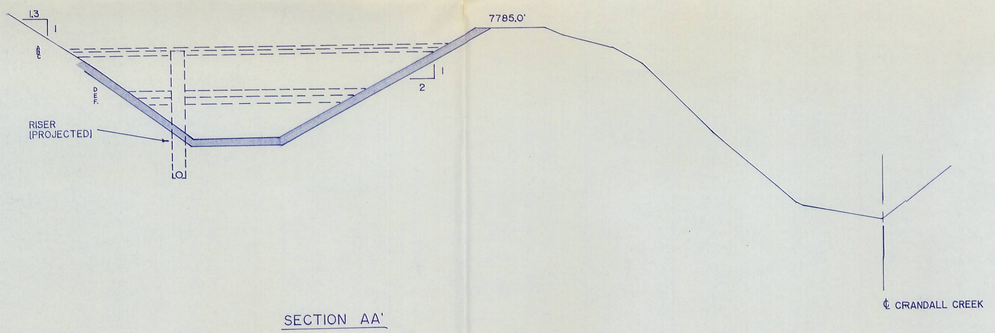

SECTION AA'

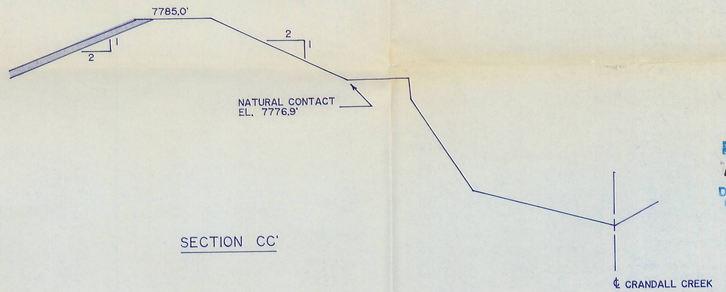

SECTION CC'

RECEIVED
AUG 7 1989
DIVISION OF OIL,
GAS & MINING
PRICE, UTAH

REGISTERED PROFESSIONAL ENGINEER
No. 7102
RICHARD B. WHITE
STATE OF UTAH

Richard B. White
10 Feb 1988

RECEIVED
AUG 08 1989
DIVISION OF
OIL, GAS & MINING

GENWAL COAL COMPANY

SEDIMENT POND CROSS SECTIONS (AS BUILT)

FEB. 10, 1988 ACK

REV. 7/89

SCALE 1" = 10'

PLATE 7-6A