


SCALE 1"=20'

SEDIMENT POND PLAN VIEW

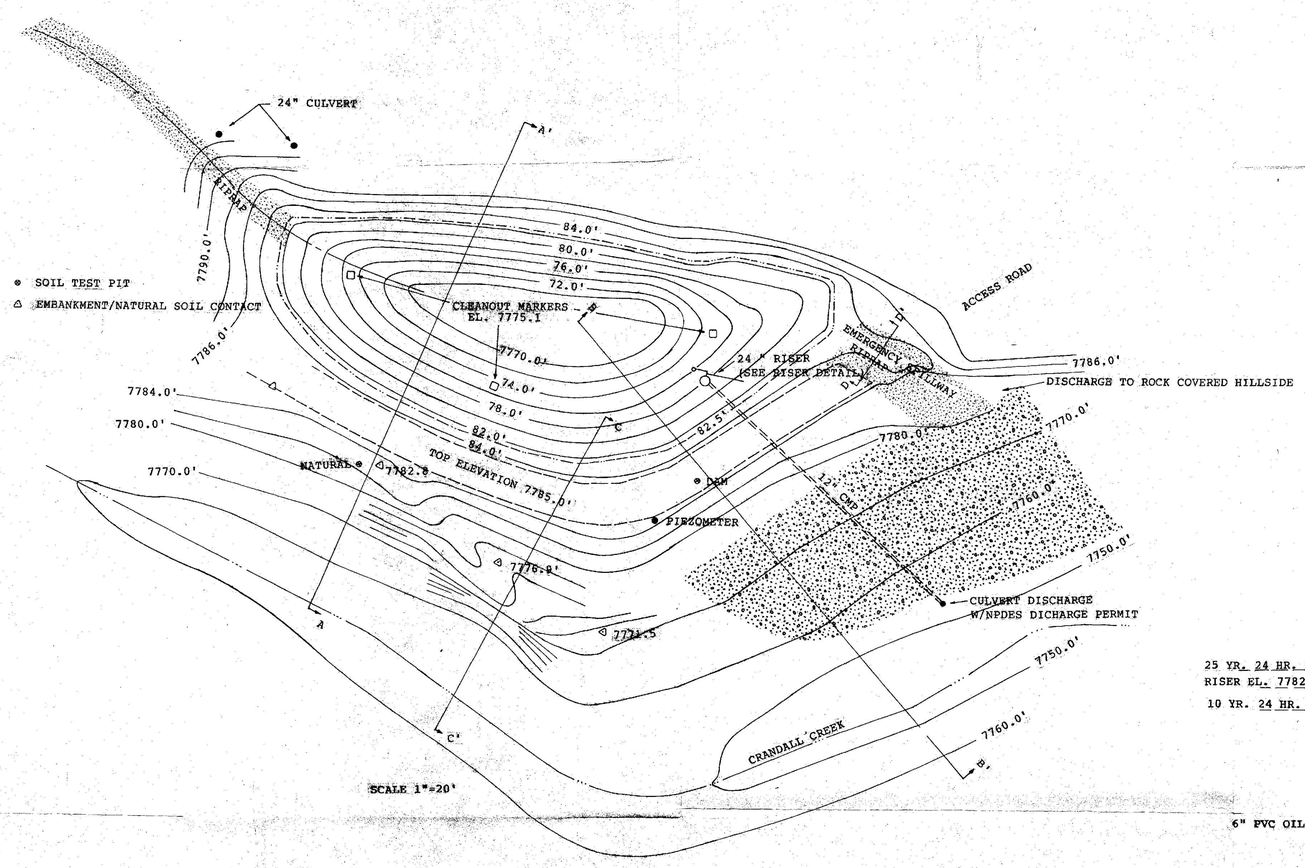


NOTE: BOTTOM OF 6" PVC CAPPED AND SEALED
2" BLACK PIPE WELDED TO RISER

SCALE 1"=2'

RISER DETAIL

NOTE--SEE PLATE 7-6a FOR AS-BUILT
CROSS-SECTIONS A-A', B-B', & C-C'

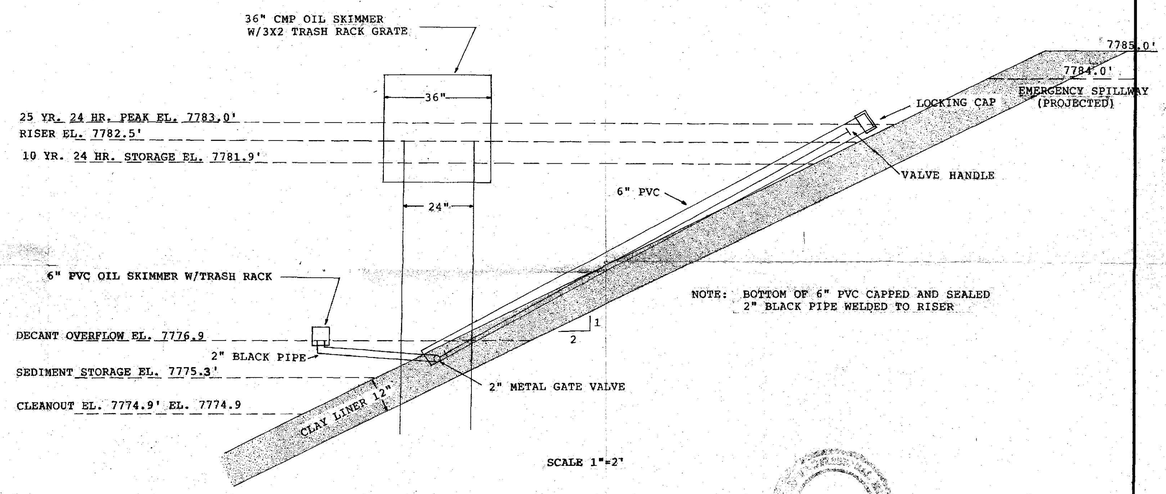LARGE RIPRAP

SMALL RIPRAP

Richard B. White
4/3/92

RECEIVED
APR 03 1992
DIVISION OF
OIL GAS & MINING

VOLUME 2 FILE COPY

| REVISION | |
|---|---|
| DATE | BY |
| 2/10/88 | ACK |
| 4/1/92 | VSB |

EarthFax Engineering, Inc.
Engineers/Scientists

PLATE 7-4A

SEDIMENT POND DETAIL
AS BUILT

GENWAL COAL COMPANY

| | | |
|---|---|---|
| DRAWN BY: ACK | CHECKED BY: | DATE: 12/30/86 |
| APPROVED BY: | PROJECT NUMBER: | |