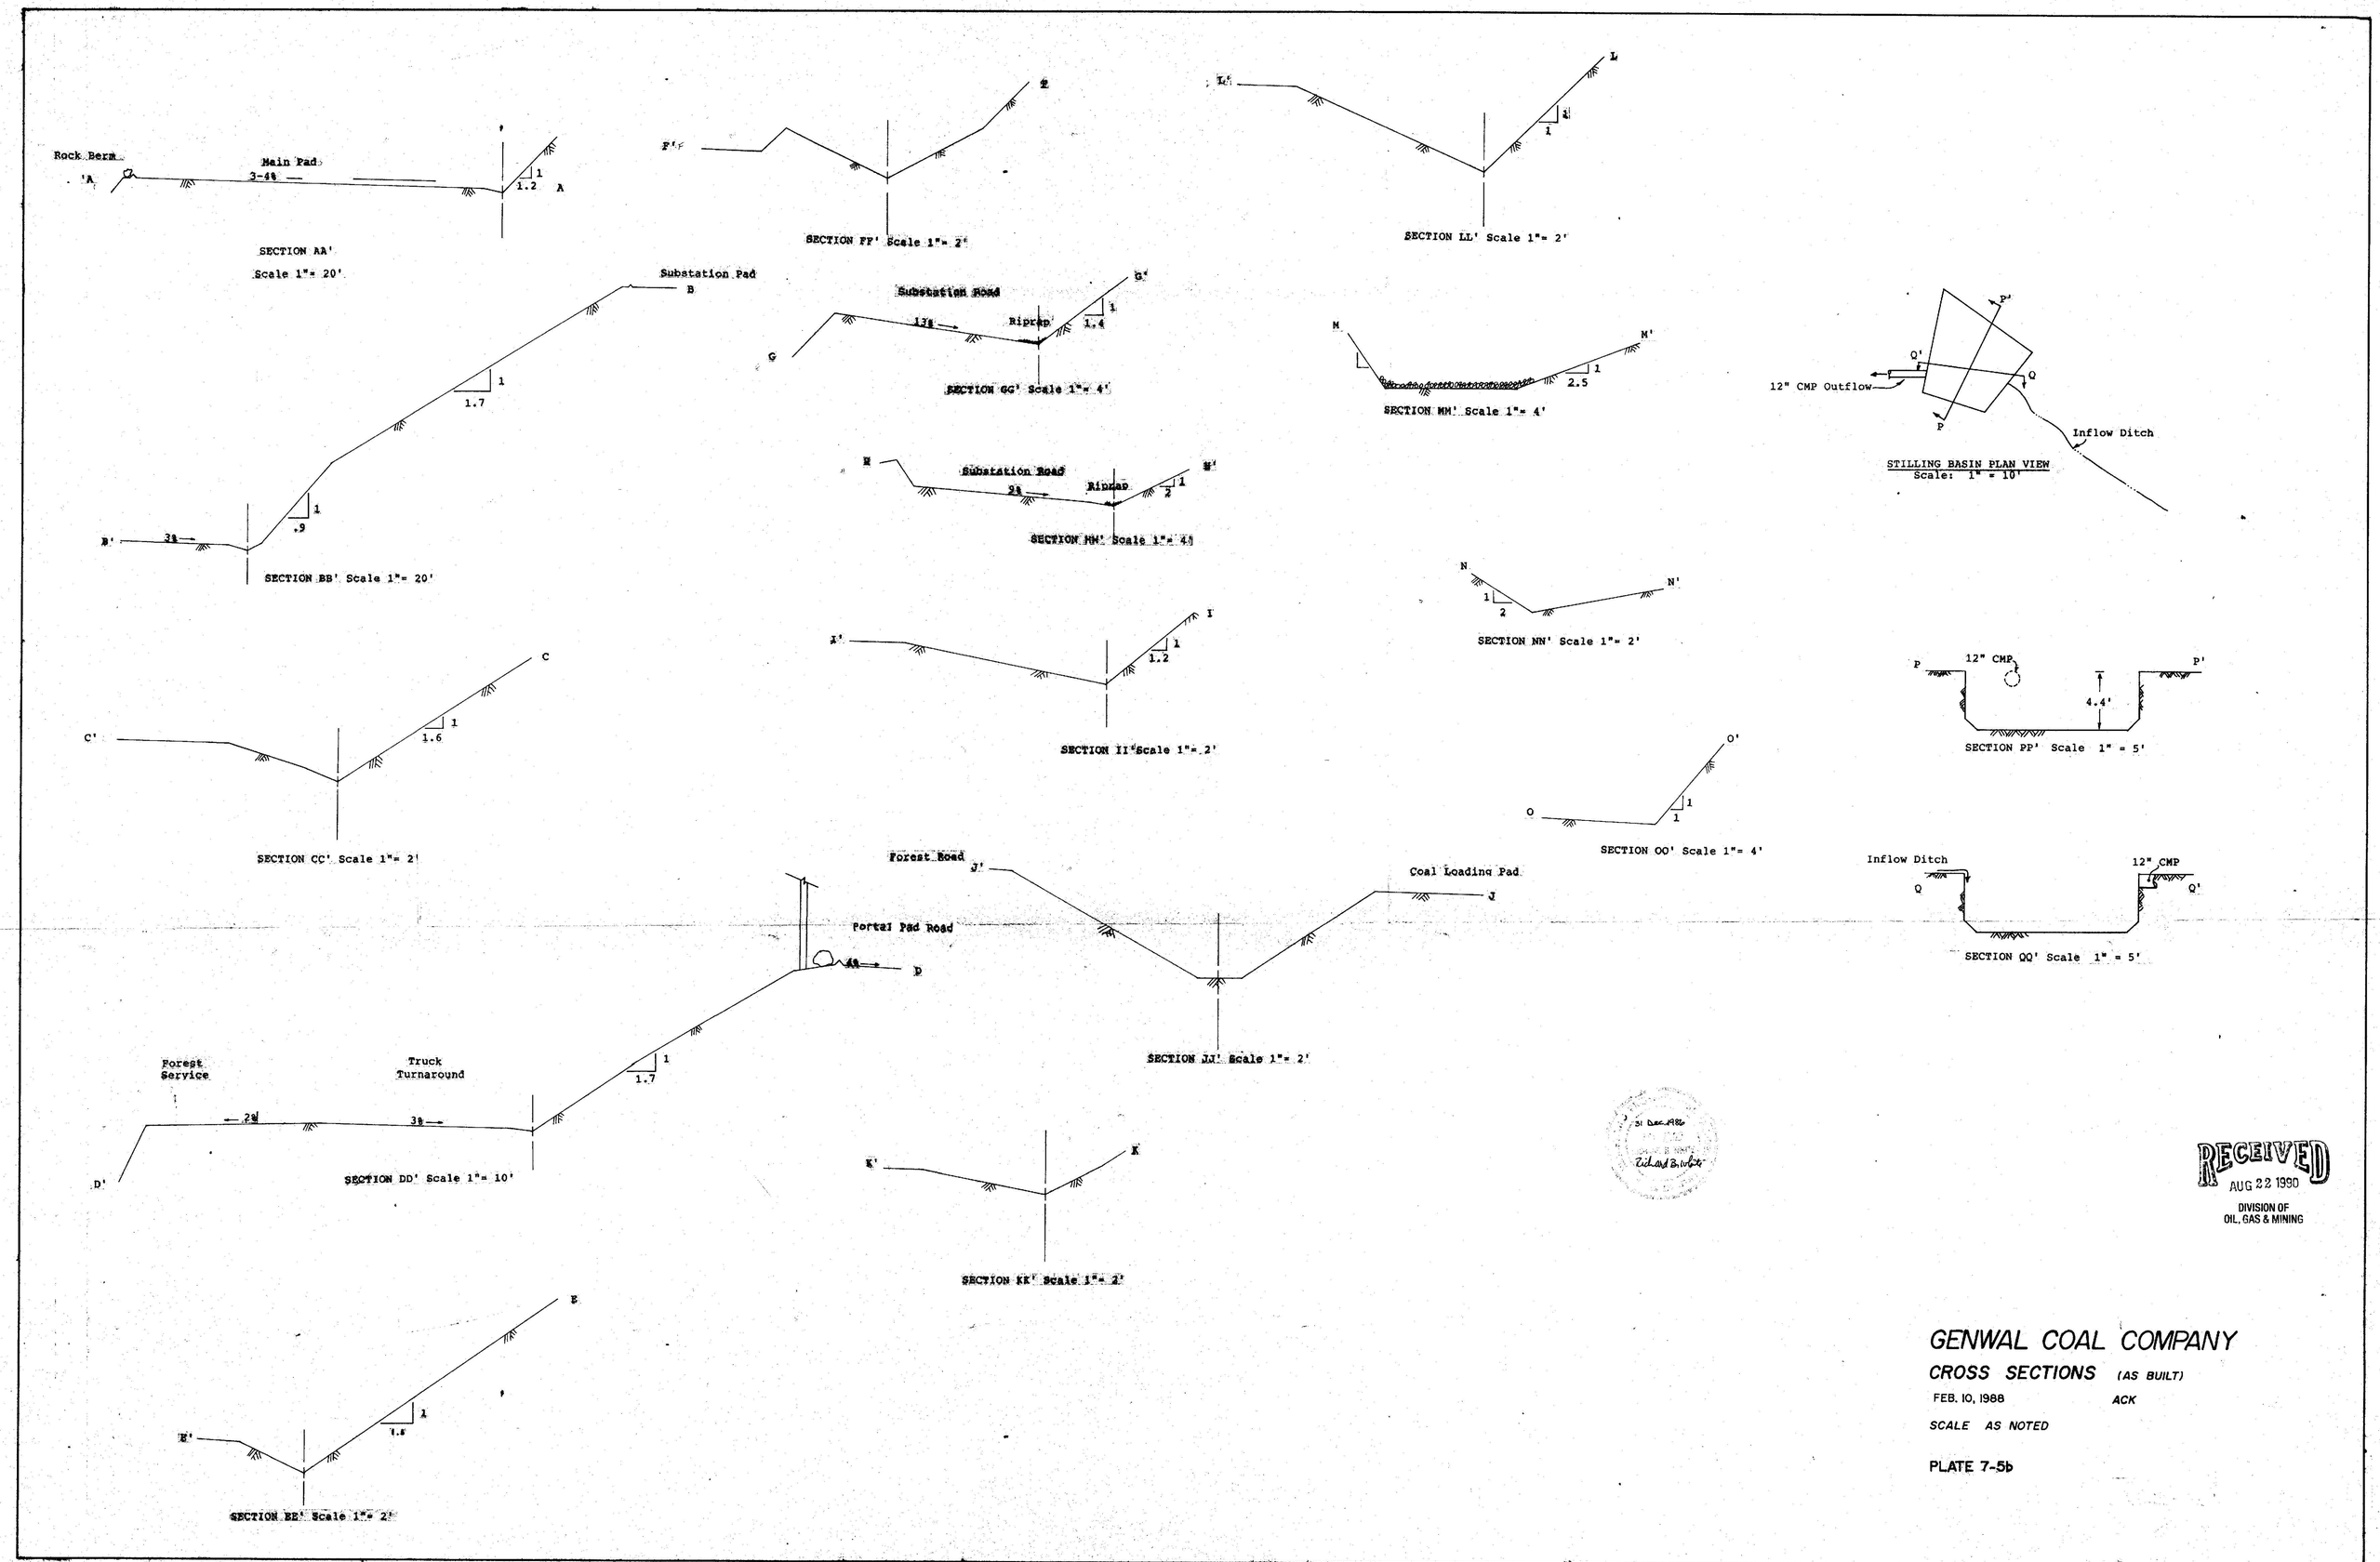

RECEIVED
AUG 22 1990
DIVISION OF
OIL, GAS & MINING

GENWAL COAL COMPANY

CROSS SECTIONS (AS BUILT)

FEB. 10, 1988 ACK

SCALE AS NOTED

PLATE 7-5b