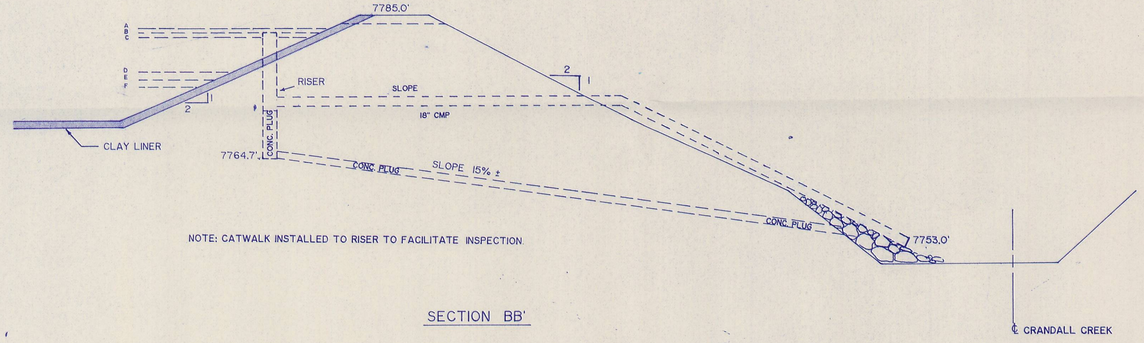

NOTE: CATWALK INSTALLED TO RISER TO FACILITATE INSPECTION.

SECTION BB'

ELEVATIONS

A 25 YR. 24 HR. PEAK EL. 7783.0'
B RISER EL. 7782.5'
C 10 YR. 24 HR. STORAGE EL. 7781.9'
D DECANT OVERFLOW EL. 7776.9'
E SEDIMENT STORAGE LEVEL EL. 7775.9'
F CLEANOUT EL. 7774.9'

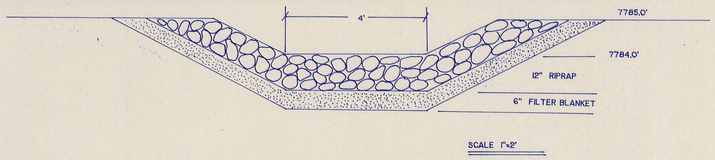

SCALE 1"=2'

SECTION DD'

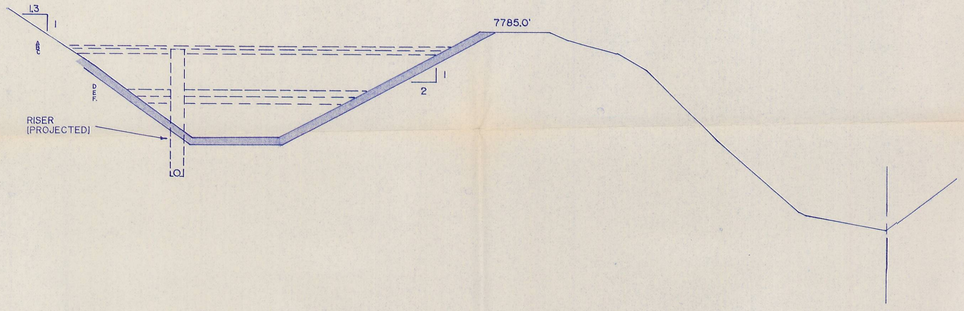

SECTION AA'

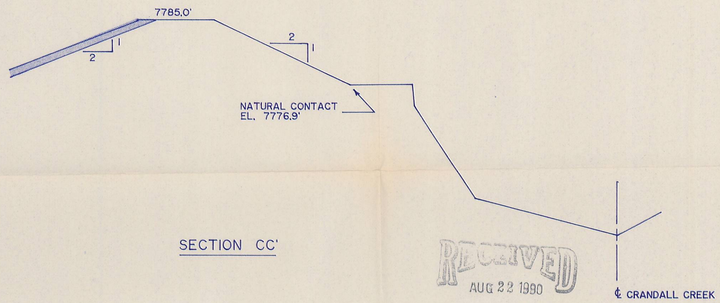

SECTION CC'

RECEIVED
AUG 22 1990
DIVISION OF
OIL, GAS & MINING

REGISTERED PROFESSIONAL ENGINEER
No. 7102
RICHARD B. WHITE
STATE OF UTAH

Richard B. White
28 Jul 1989

GENWAL COAL COMPANY

SEDIMENT POND CROSS SECTIONS (AS BUILT)

FEB. 10, 1988 ACK

REV. 7/89
SCALE 1" = 10'

PLATE 7-6A