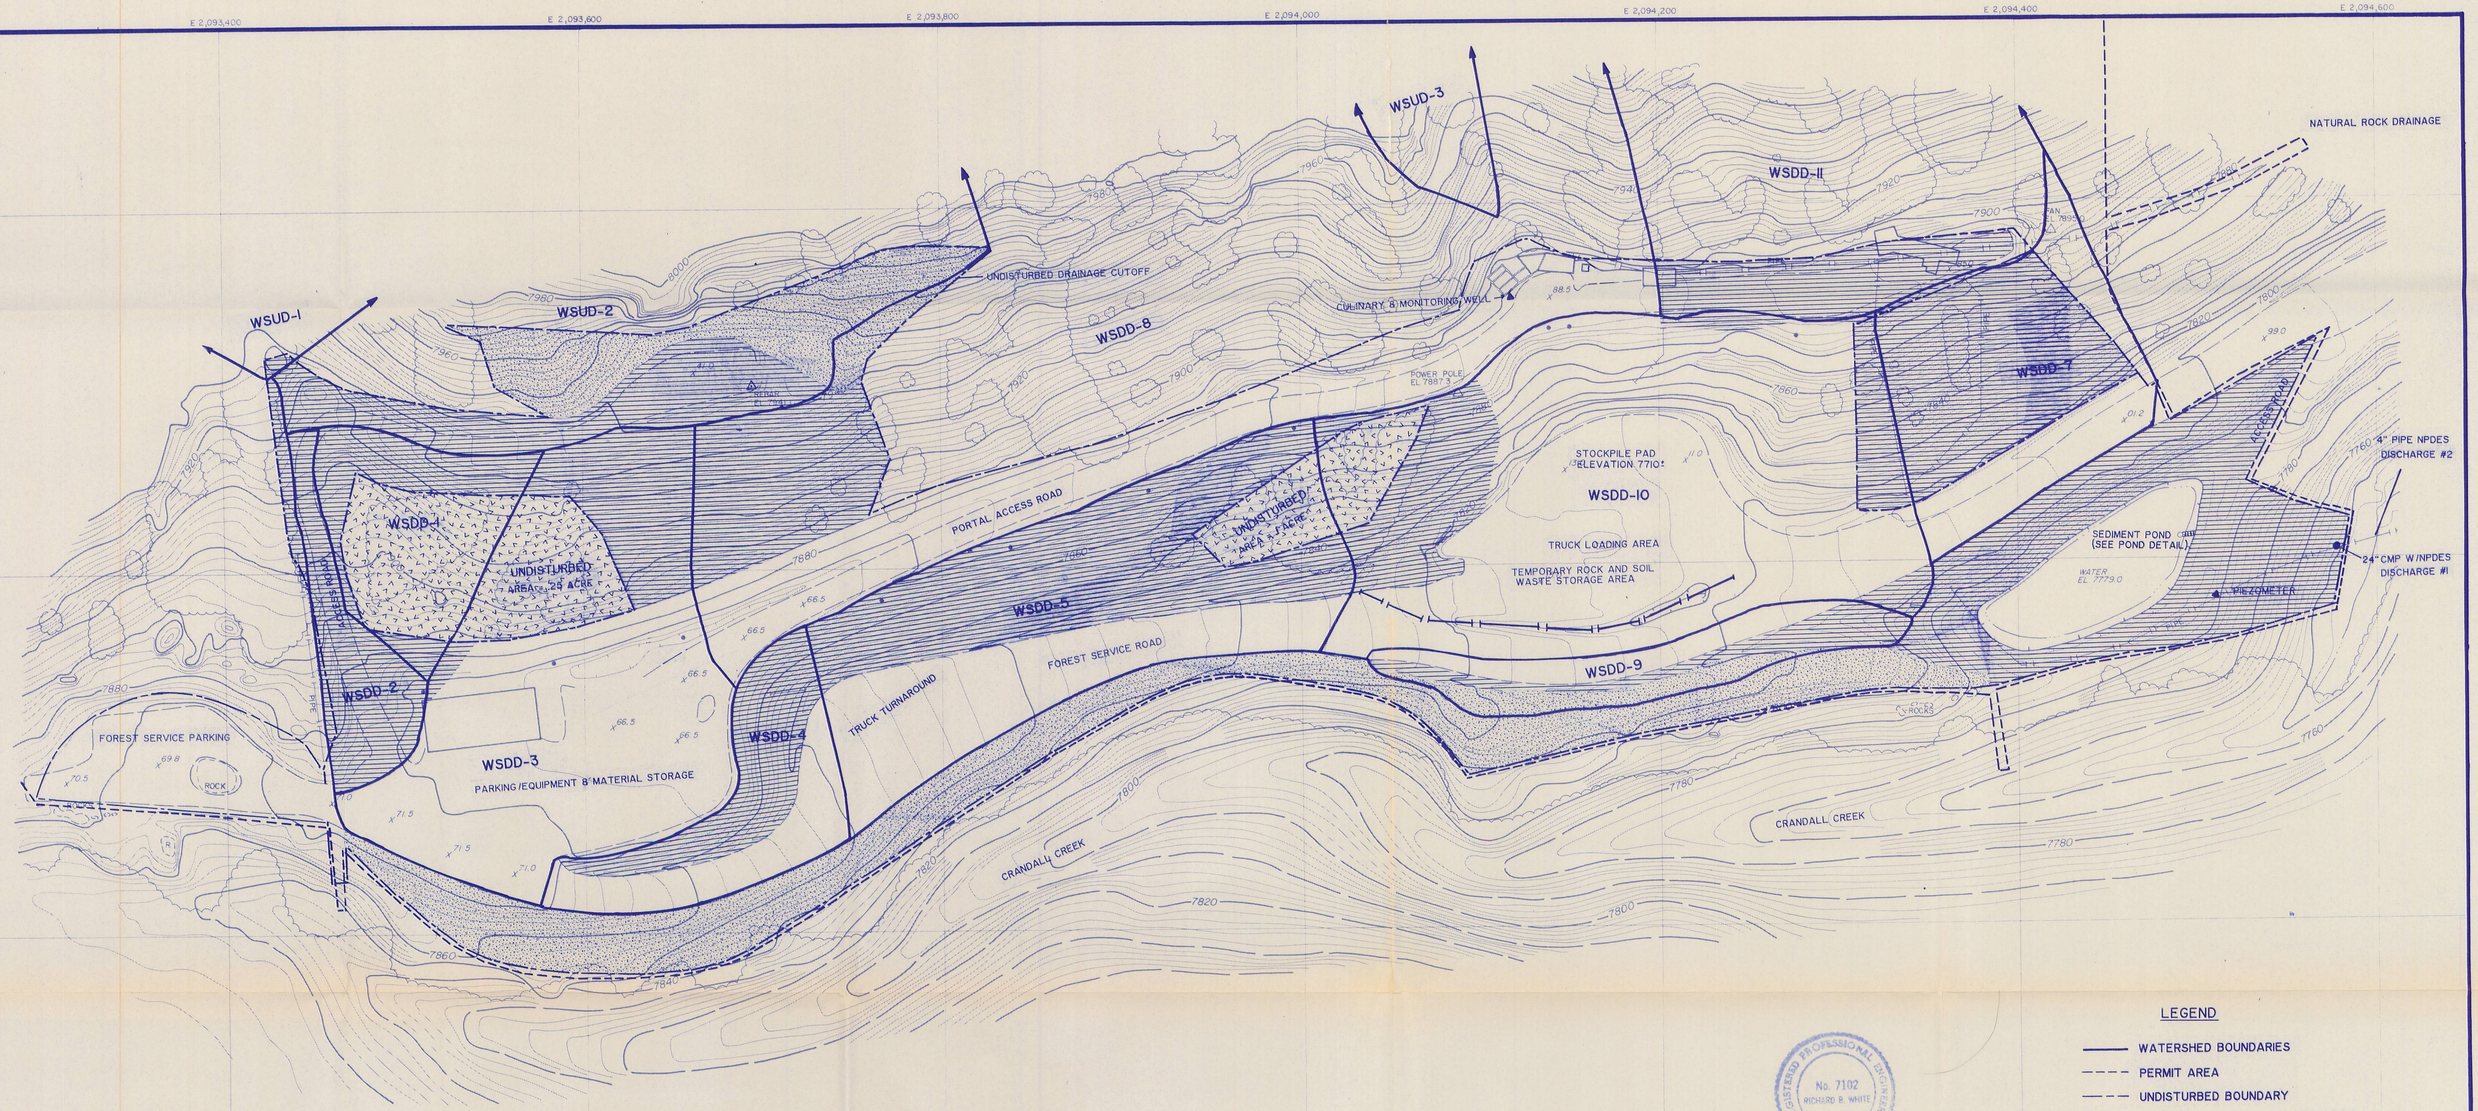

LEGEND

- WATERSHED BOUNDARIES
- PERMIT AREA
- UNDISTURBED BOUNDARY
- CONTEMPORANEOUS RECLAMATION
- UNDISTURBED AREA
- FINAL RECLAMATION

REGISTERED PROFESSIONAL ENGINEER No. 7102 RICHARD B. WHITE STATE OF UTAH

Richard B. White
30 Nov 1989

RECEIVED
AUG 22 1990
DIVISION OF OIL, GAS & MINING

SCALE 1" = 40'
40' 20' 0 40' 80' 120'
CONTOUR INTERVAL 2'
PHOTOGRAPHY DATE OCT. 25, 1988

PLATE 7-5C
WATERSHED BOUNDARIES (AS-BUILT)
12/20/89.

GENWAL COAL COMPANY
P.O. BOX 1201 HUNTINGTON, UTAH
CRANDALL CANYON MINE