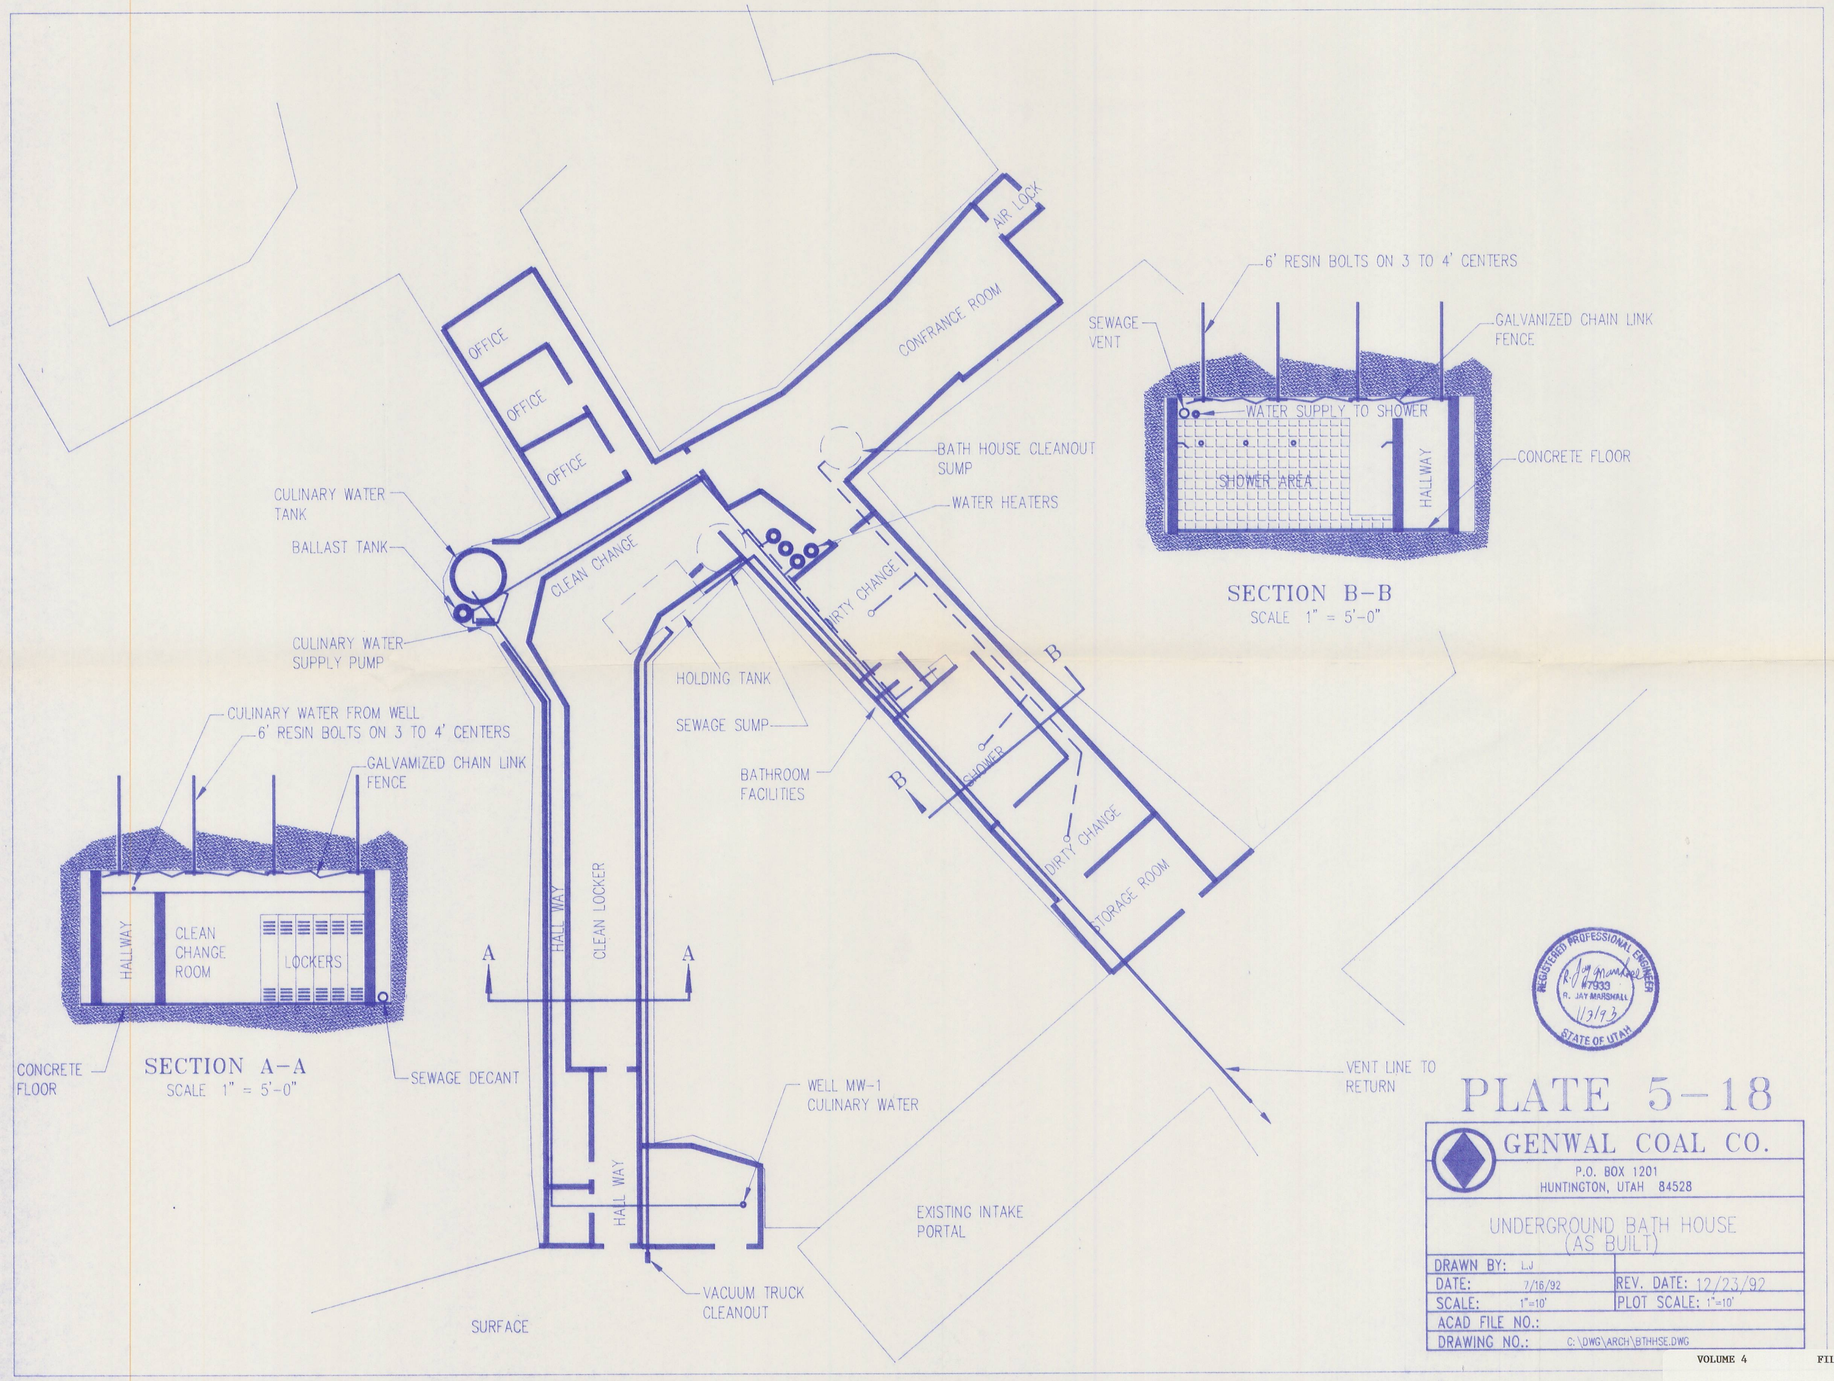

SECTION A–A
SCALE 1" = 5'-0"

SECTION B–B
SCALE 1" = 5'-0"

RECEIVED
JAN 12 1993
DIVISION OF
OIL GAS & MINING

REGISTERED PROFESSIONAL ENGINEER
#7933
R. JAY MARSHALL
1/3/93
STATE OF UTAH

PLATE 5–18

GENWAL COAL CO.
P.O. BOX 1201
HUNTINGTON, UTAH 84528

UNDERGROUND BATH HOUSE
(AS BUILT)

DRAWN BY: LJ	
DATE: 7/16/92	REV. DATE: 12/23/92
SCALE: 1"=10'	PLOT SCALE: 1"=10'
ACAD FILE NO.:	
DRAWING NO.: C:\DWG\ARCH\BTHHSE.DWG	

VOLUME 4 FILE COPY