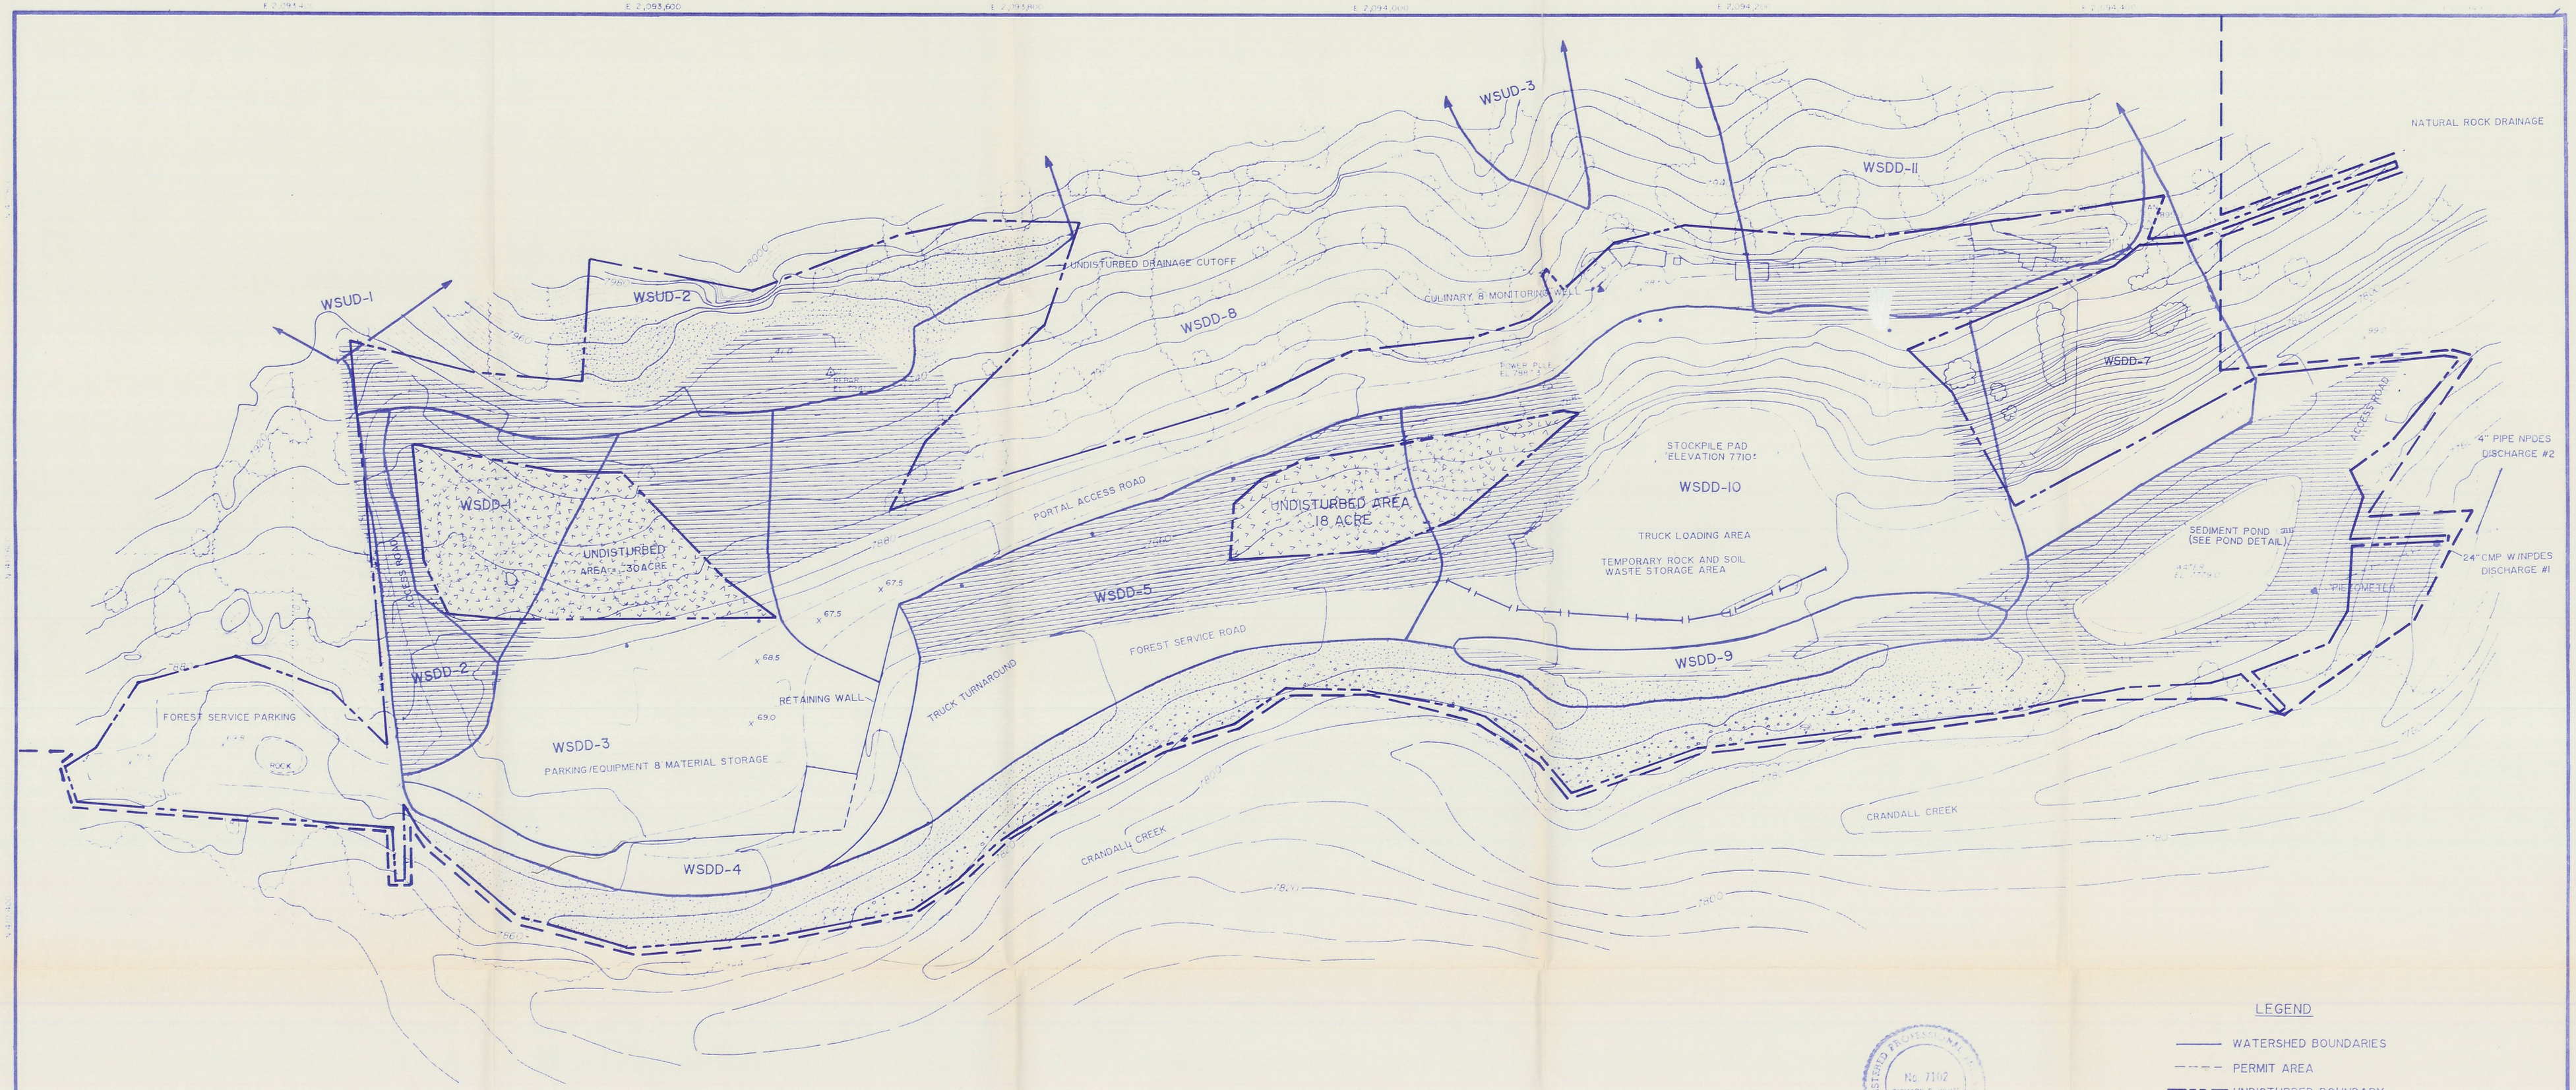

REGISTERED PROFESSIONAL ENGINEER No. 7102 RICHARD B. WHITE STATE OF UTAH

Richard B. White
30 Nov 1989

LEGEND

- WATERSHED BOUNDARIES
- PERMIT AREA
- UNDISTURBED BOUNDARY
- CONTEMPORANEOUS RECLAMATION
- UNDISTURBED AREA
- FINAL RECLAMATION

N

SCALE 1" = 40'

40' 20' 0 40' 80' 120'

CONTOUR INTERVAL 2'
PHOTOGRAPHY DATE OCT. 25, 1988

PLATE 7-5C
WATERSHED BOUNDARIES (AS-BUILT)
10/9/90

GENWAL COAL COMPANY
P.O. BOX 1201 HUNTINGTON, UTAH
CRANDALL CANYON MINE