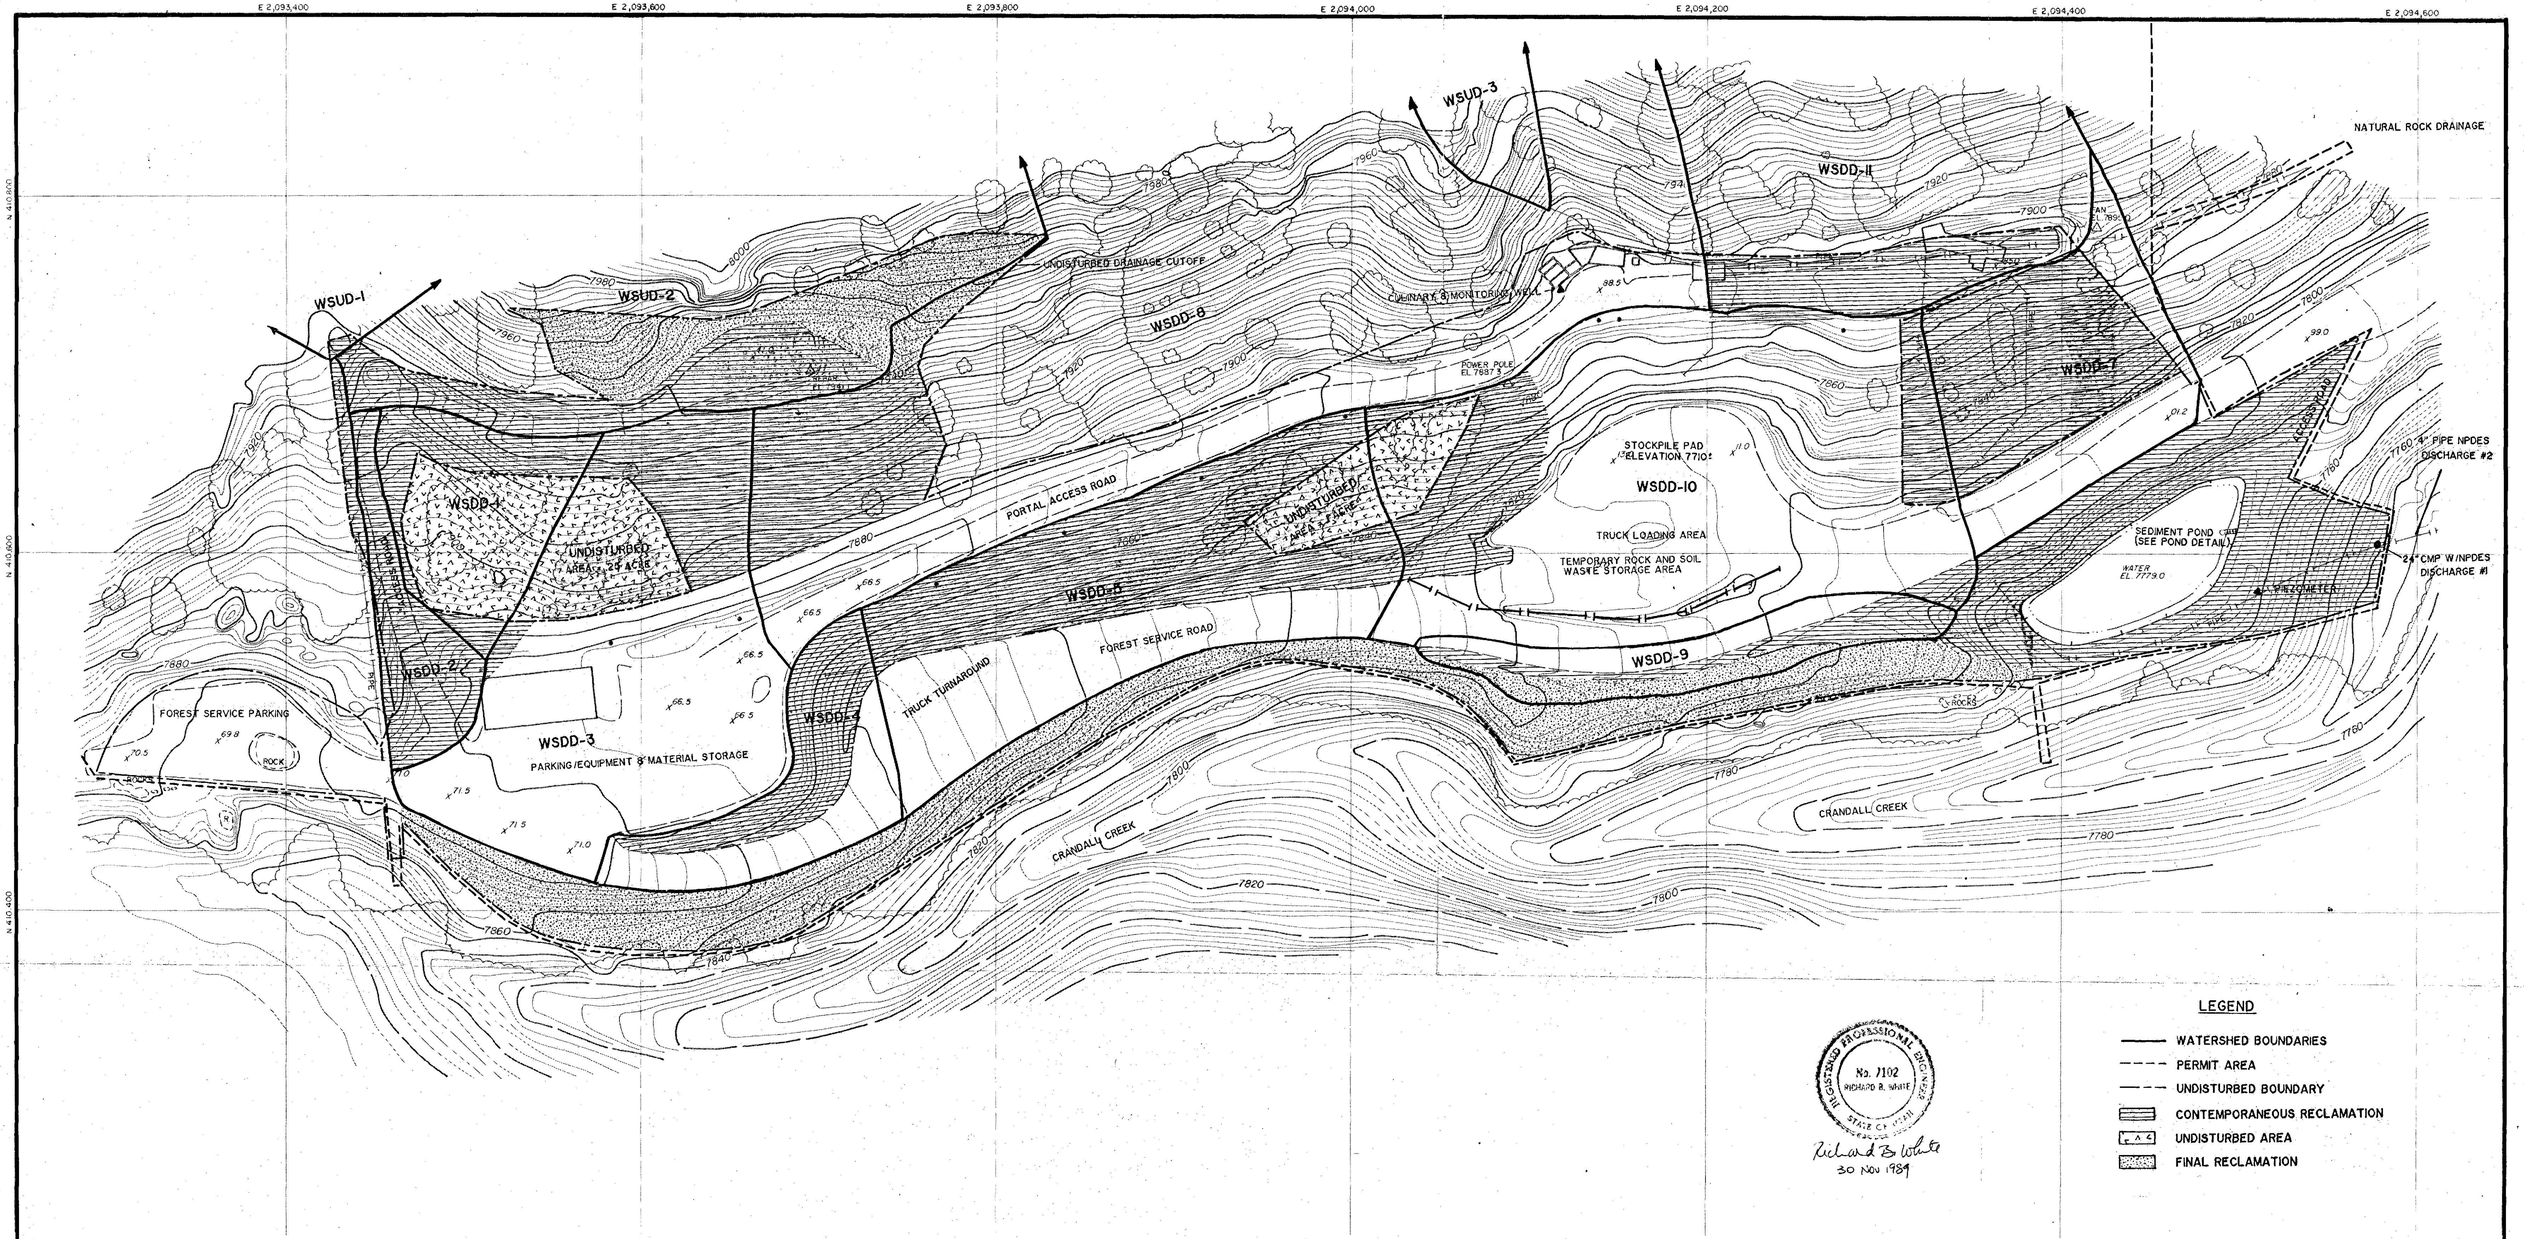

RECEIVED
AUG 22 1990
DIVISION OF
OIL, GAS & MINING

PLATE 7-5C
WATERSHED BOUNDARIES (AS-BUILT)
12/20/89.

GENWAL COAL COMPANY
P.O. BOX 1201 HUNTINGTON, UTAH
CRANDALL CANYON MINE