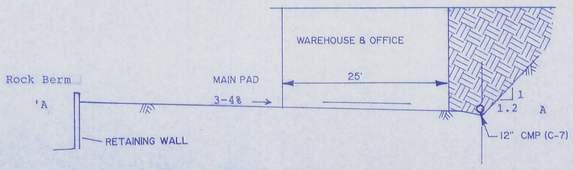

SECTION AA'
Scale 1"= 20'

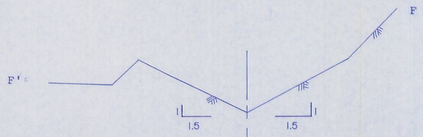

SECTION FF' Scale 1"= 2'

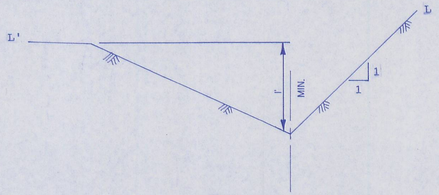

SECTION LL' Scale 1"= 2'

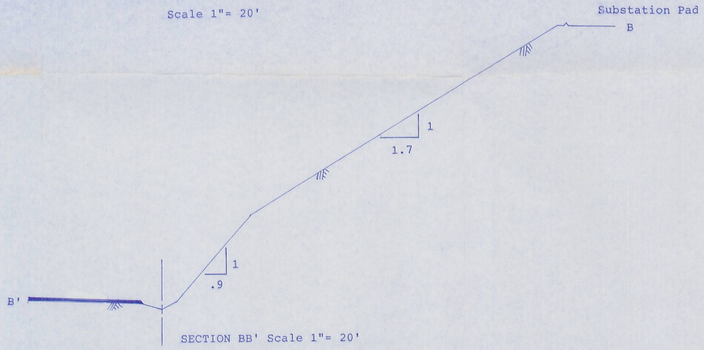

SECTION BB' Scale 1"= 20'

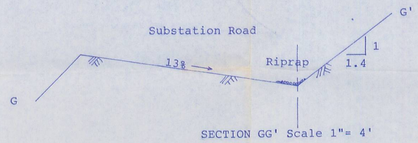

SECTION GG' Scale 1"= 4'

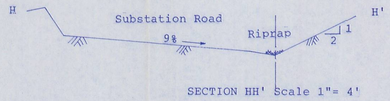

SECTION HH' Scale 1"= 4'

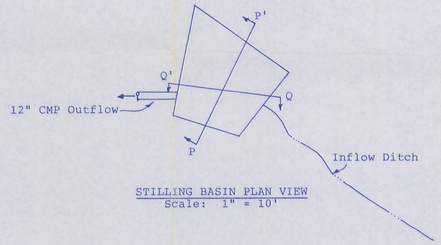

STILLING BASIN PLAN VIEW
Scale: 1" = 10'

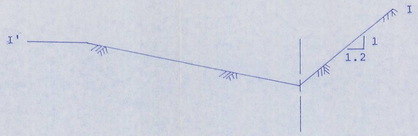

SECTION II'Scale 1"= 2'

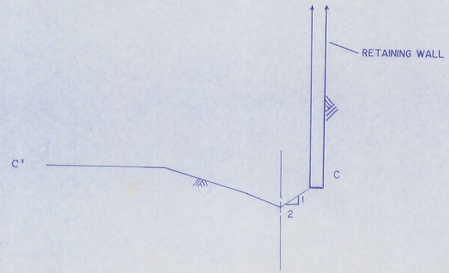

SECTION CC' Scale 1"= 2'

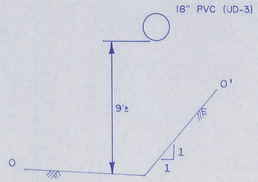

SECTION OO' Scale 1"= 4'

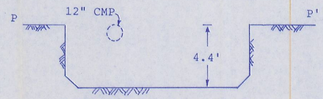

SECTION PP' Scale 1" = 5'

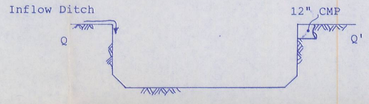

SECTION QQ' Scale 1" = 5'

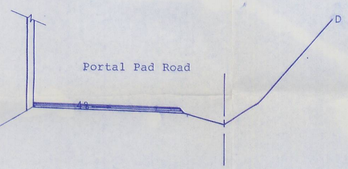

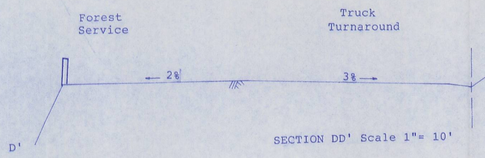

SECTION DD' Scale 1"= 10'

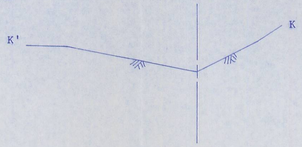

SECTION KK' Scale 1"= 2'

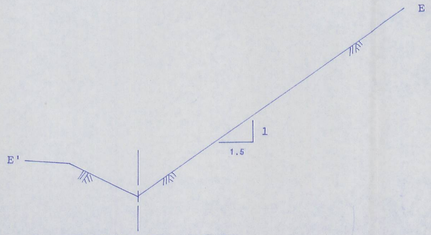

SECTION EE' Scale 1"= 2'

REGISTERED PROFESSIONAL ENGINEER
No. 7333
R. JAY MARSHALL
9/8/94
STATE OF UTAH

REVISED
2/21/94

GENWAL COAL COMPANY

CROSS SECTIONS (AS BUILT)

10/9/90 ACK

SCALE AS NOTED

PLATE 7-5b

NOTE: SEE PLATE 5-10 FOR ROAD CROSS-SECTIONS