0026

Document Information Form

Mine Number: C/015/0032

File Name: Crandall Canyon Mine

To: Internal File

From:

Person Tom Lloyd

Company Manti La Sal NF

Date Sent: 11/16/07

Explanation:

These exhibits were distributed during the 11/16/07 meeting about the ~~drilling~~ remaining reclamation of the Crandall Canyon drill holes and pads.

cc:

Attachment for Meeting Notes of 11/16/07

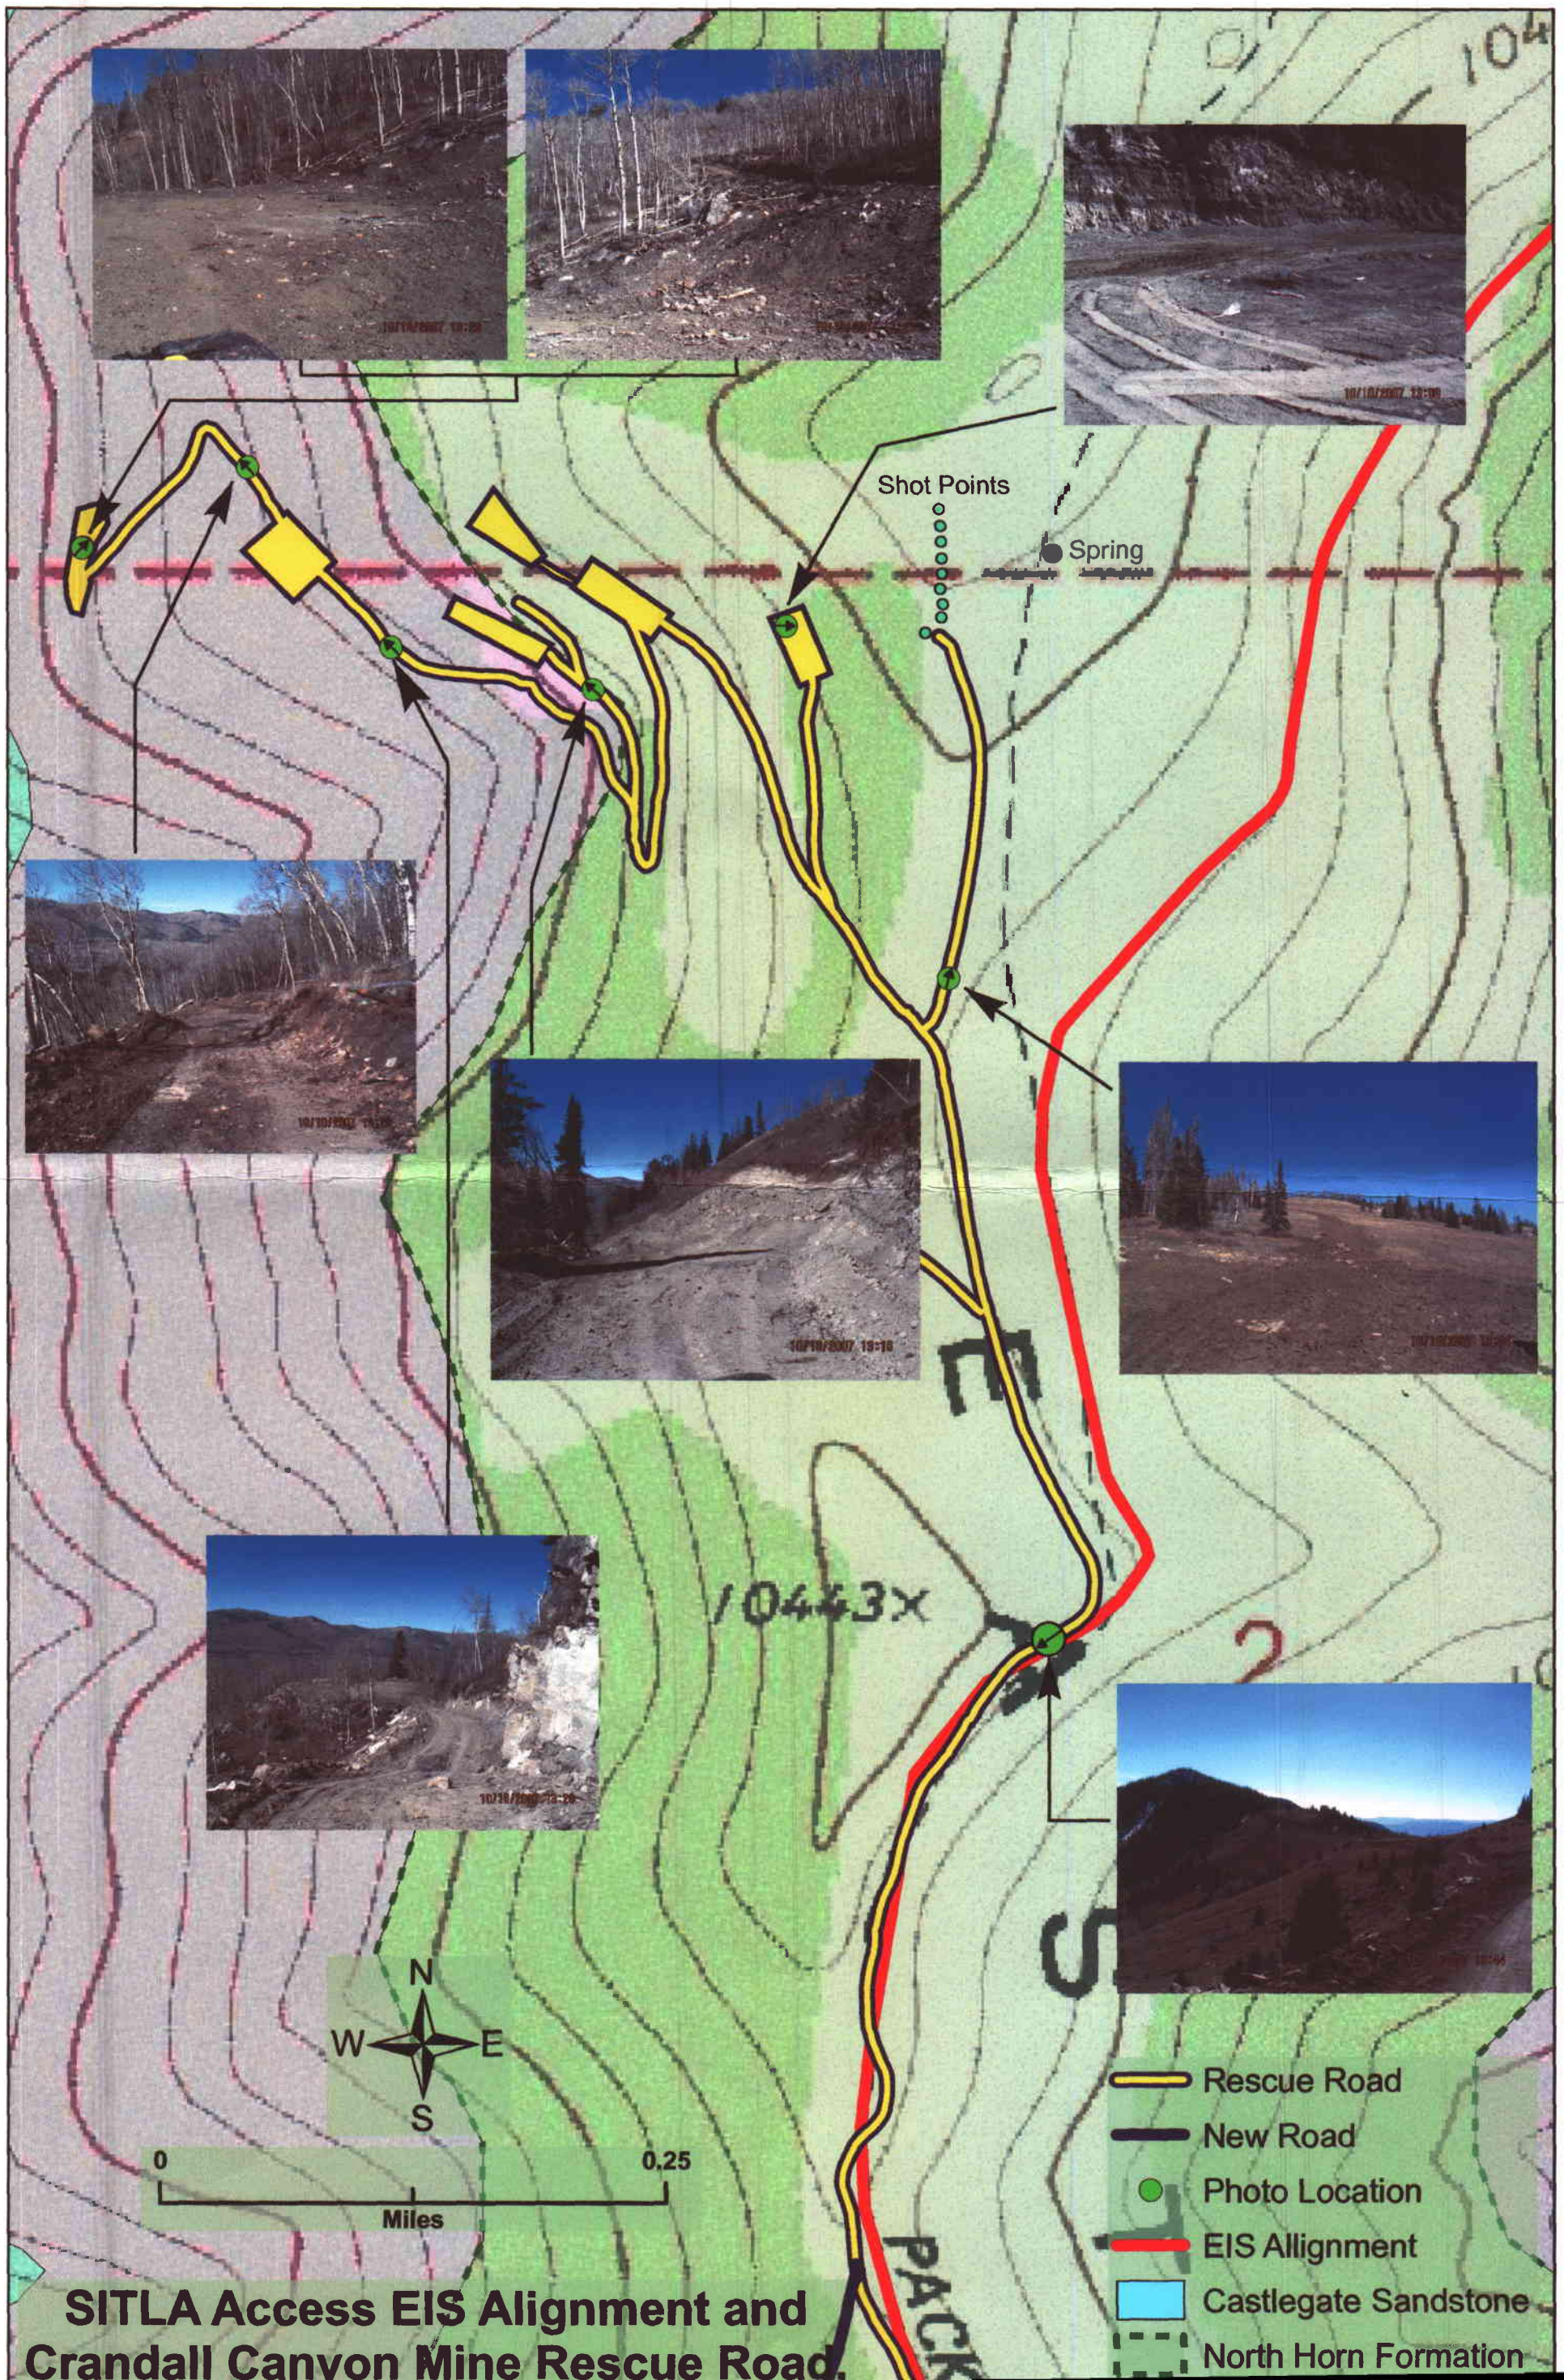

SITLA Access EIS Alignment and Crandall Canyon Mine Rescue Road

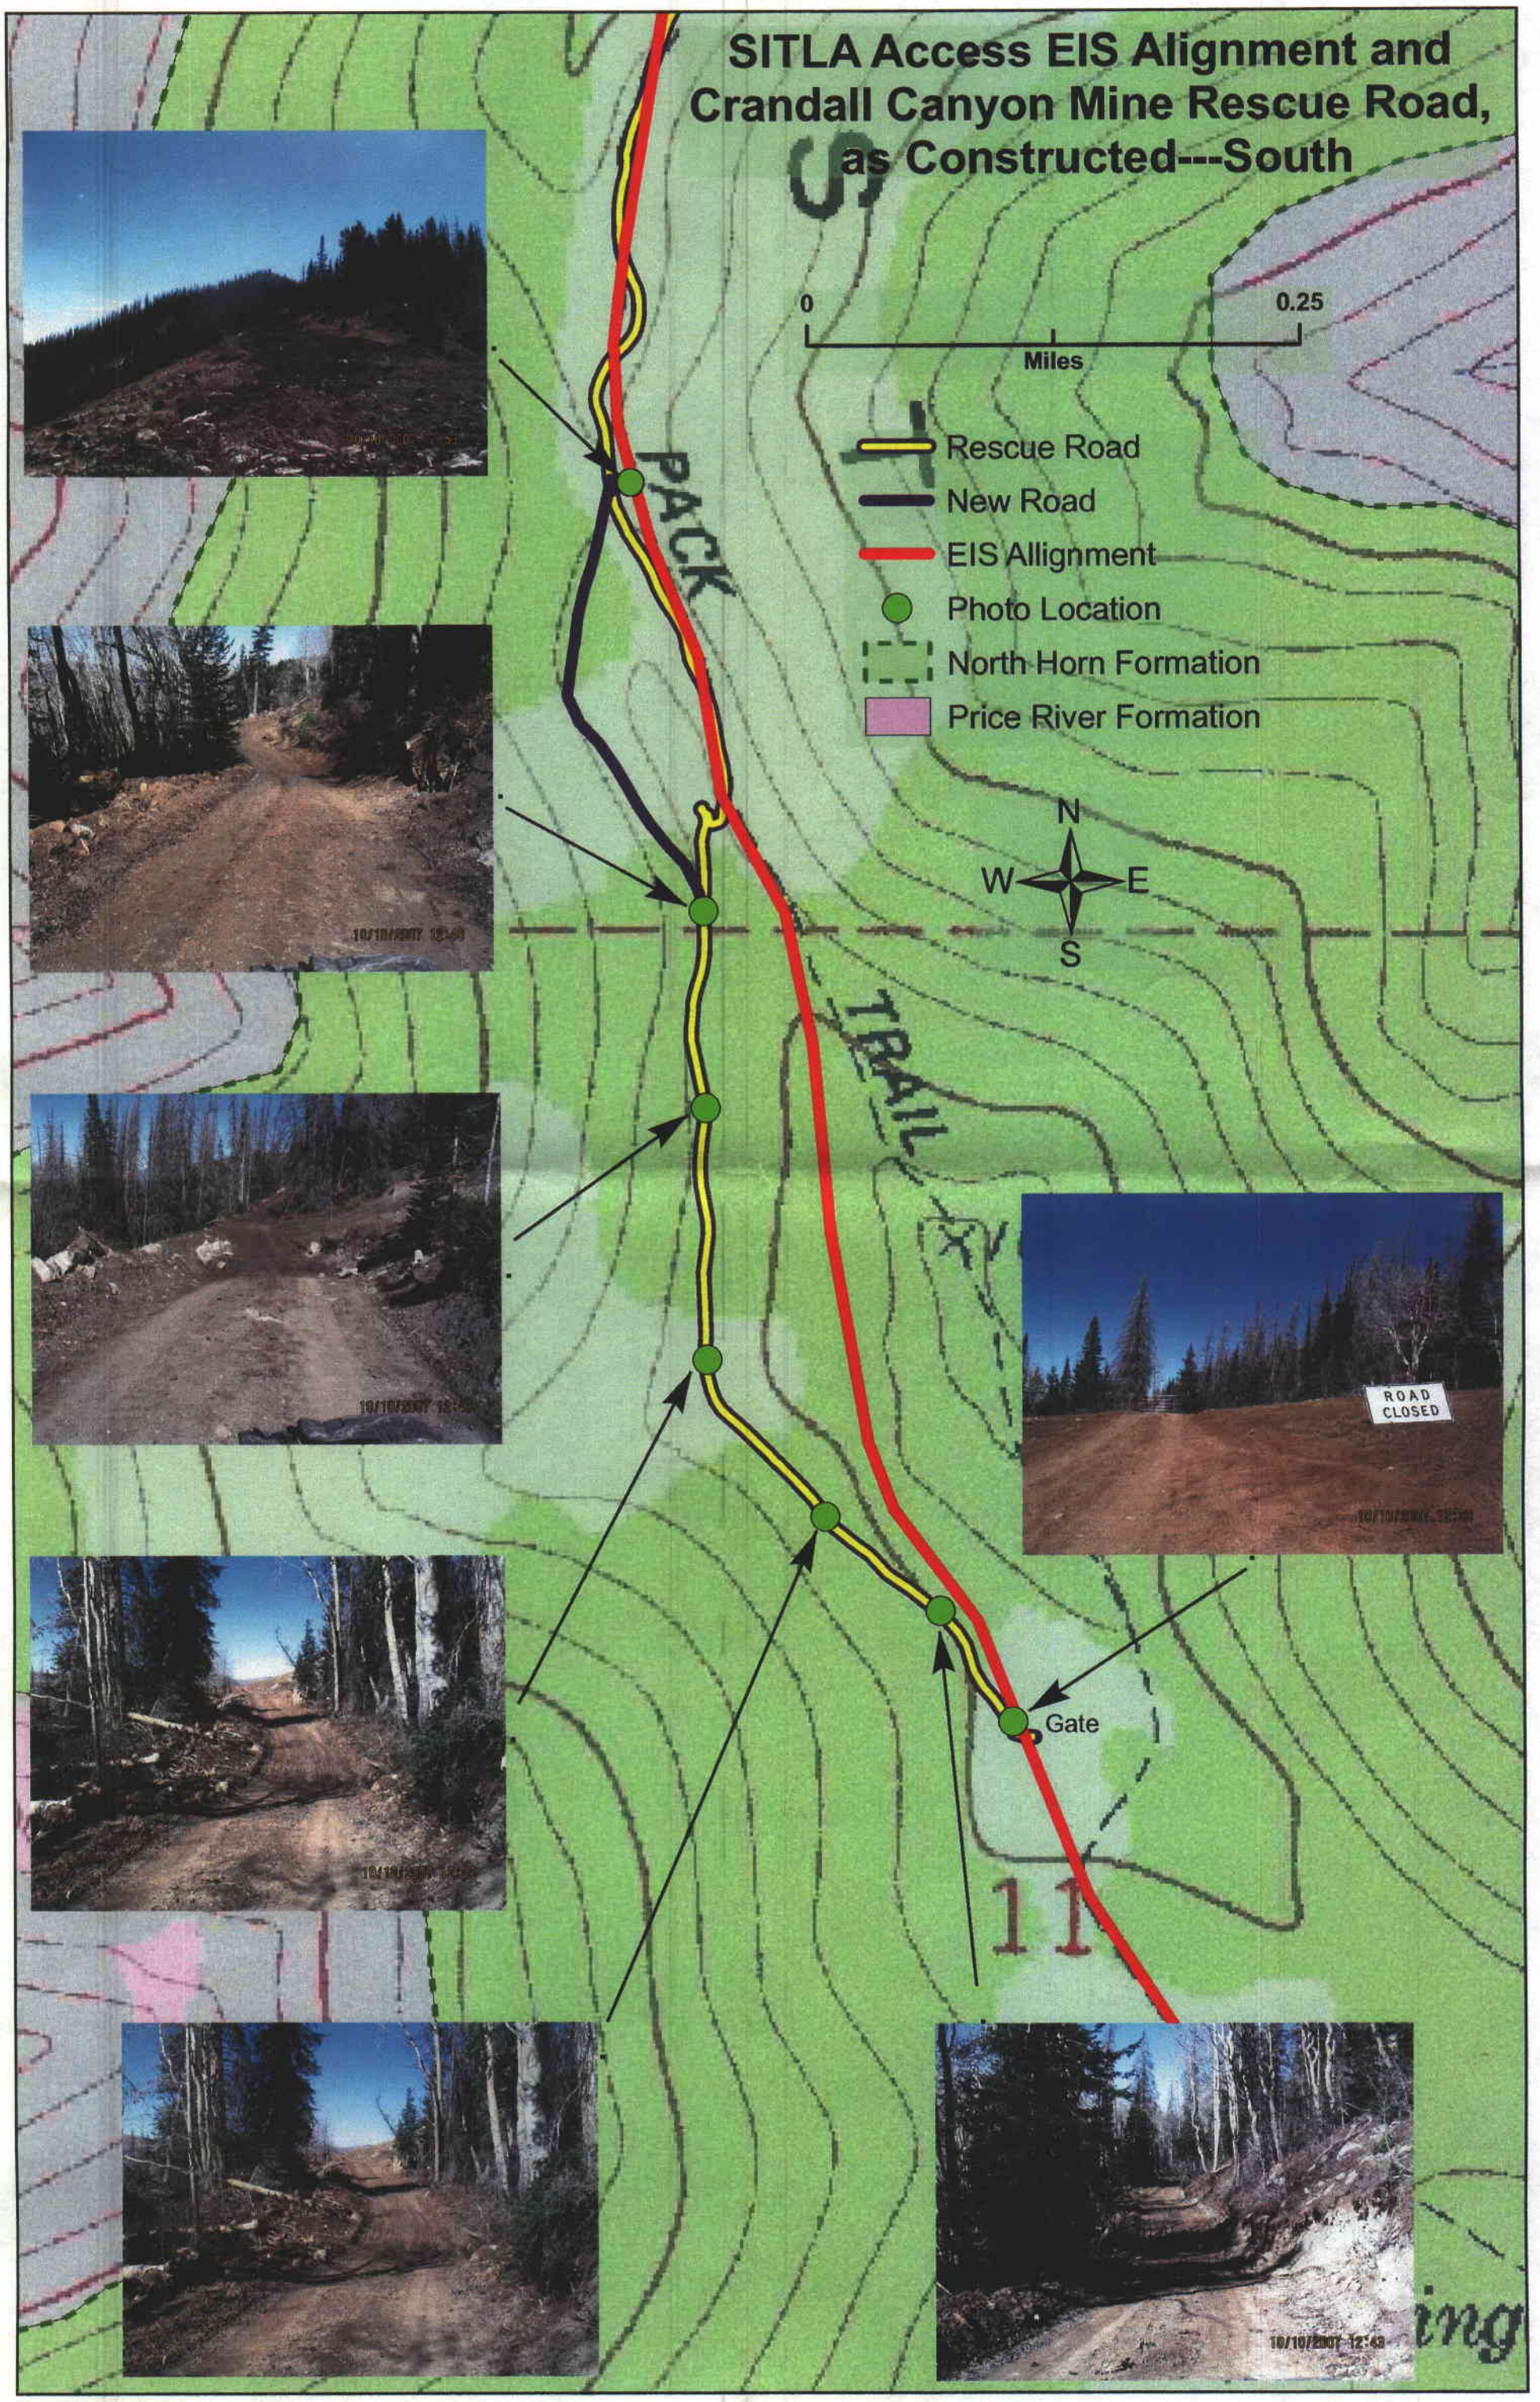
SITLA Access EIS Alignment and
Crandall Canyon Mine Rescue Road,
as Constructed---South
0
0.25
Miles
Rescue Road
New Road
EIS Alignment
Photo Location
North Horn Formation
Price River Formation
N
W
E
S
PACK
TRAIL
ROAD
CLOSED
Gate
10/10/2007 12:43

4/015/0032

Internal C/015/0032

early Sept. 2007