RECEIVED
JUL 05 2011
DIV. OF OIL, GAS & MINING

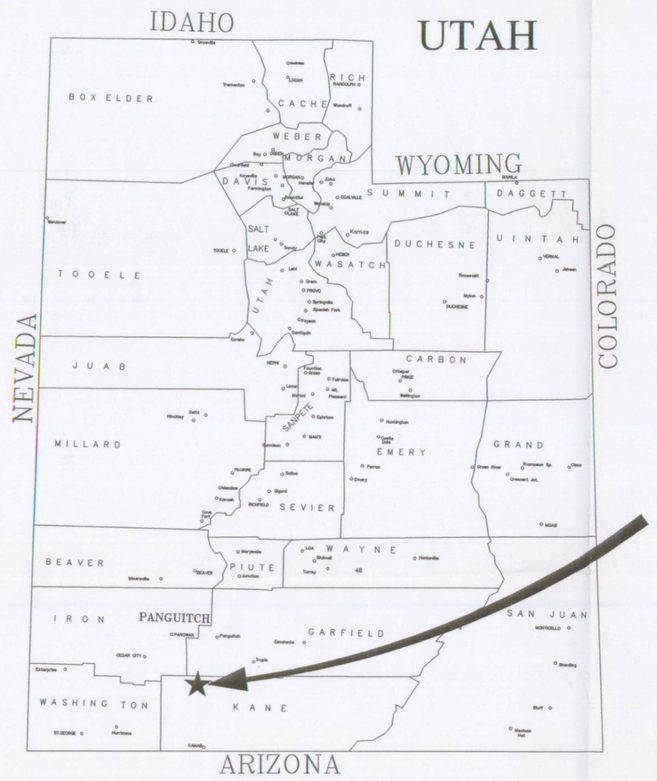

PROJECT LOCATION

ALTON COAL DEVELOPMENT, LLC
COAL HOLLOW PROJECT
ALTON, UT

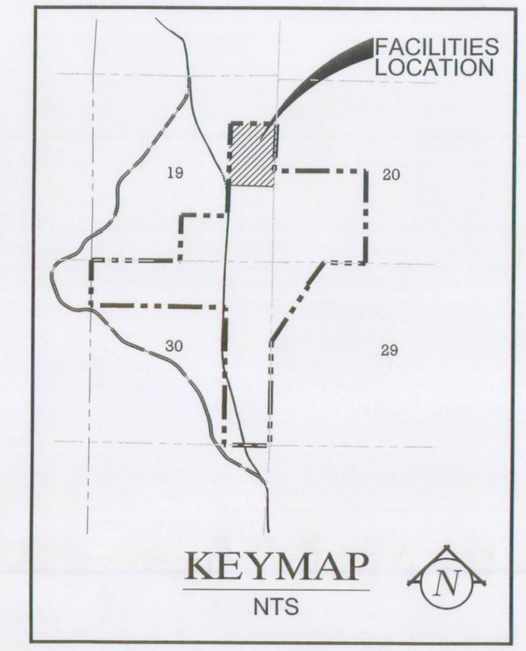

SHEET INDEX

SHEET #	SHEET DESCRIPTION
C0.0	TITLE SHEET
C1.0	PLAN - OVERALL PROJECT
C1.1	FACILITIES GRADING & GRAVEL AREAS, & BERM PLAN
C2.0	FUEL CONTAINMENT
C3.0	EQUIPMENT WASH BAY (FUTURE)
C4.0	WATER SYSTEM PLAN (NOT COMPLETED AS OF 4-19-2011)
C5.0	ROBINSON CREEK TEMPORARY DIVERSION PLAN VIEW
C5.1	ROBINSON CREEK TEMPORARY DIVERSION DESIGN & DETAILS
C6.0	PRIMARY MINE HAUL ROAD CULVERT PLAN
C6.1	PRIMARY MINE HAUL ROAD CULVERT DETAILS
C7.0	PRIMARY ROADWAYS - FACILITIES ROADWAY (COAL TRUCK ROAD) -PLAN & PROFILE
C7.1	PRIMARY ROADWAYS - FACILITIES ROADWAY - PLAN & PROFILE
C8.1	DIVERSION DITCH 2 - PLAN & PROFILE
C8.2	DIVERSION DITCH 3 - PLAN & PROFILE
C9.0	SEDIMENT IMPOUNDMENT POND 1 DETAILS
C9.1	SEDIMENT IMPOUNDMENT POND 1B DETAILS
C9.2	SEDIMENT IMPOUNDMENT POND 2 DETAILS
C9.3	SEDIMENT IMPOUNDMENT POND 3 DETAILS

RECORD DRAWING

CONSULTANT:
LESLIE & ASSOCIATES
444 South Main Street
Cedar City, Utah 84720
Phone (435)586-9474
FAX (435)586-8399
CIVIL ENGINEERS
LAND SURVEYORS

DRAWN BY: R. SPENCER	CHECKED BY: JDE
DRAWING:	DATE: 11 /08 /2010
	SCALE: N.T.S.
JOB NUMBER: 594-01-01	

REVISIONS

DATE:	BY:
4/19/2011	KRB

TITLE SHEET

COAL HOLLOW PROJECT
ALTON, UTAH

DRAWING: C0.0

LICENSED PROFESSIONAL ENGINEER
No. 348930
KERRY ROBERT BENSON
STATE OF UTAH
4-19-2011

Alton Coal Development
Coal Hollow Project
463 North 100 West, Suite 1
Cedar City, Utah 84720
Phone (435) 867-5331
Fax (435) 867-1192

File in: ☐ Confidential ☒ Shelf ☐ Expandable
Date Placed: 07/05/2011

\\Sbs\data\594_ALTON_COAL_KANE_MINING\01-COAL_HOLLOW_PROJECT\dwg\TITLESHEET.dwg April 21 2011 8:42am By:Owner