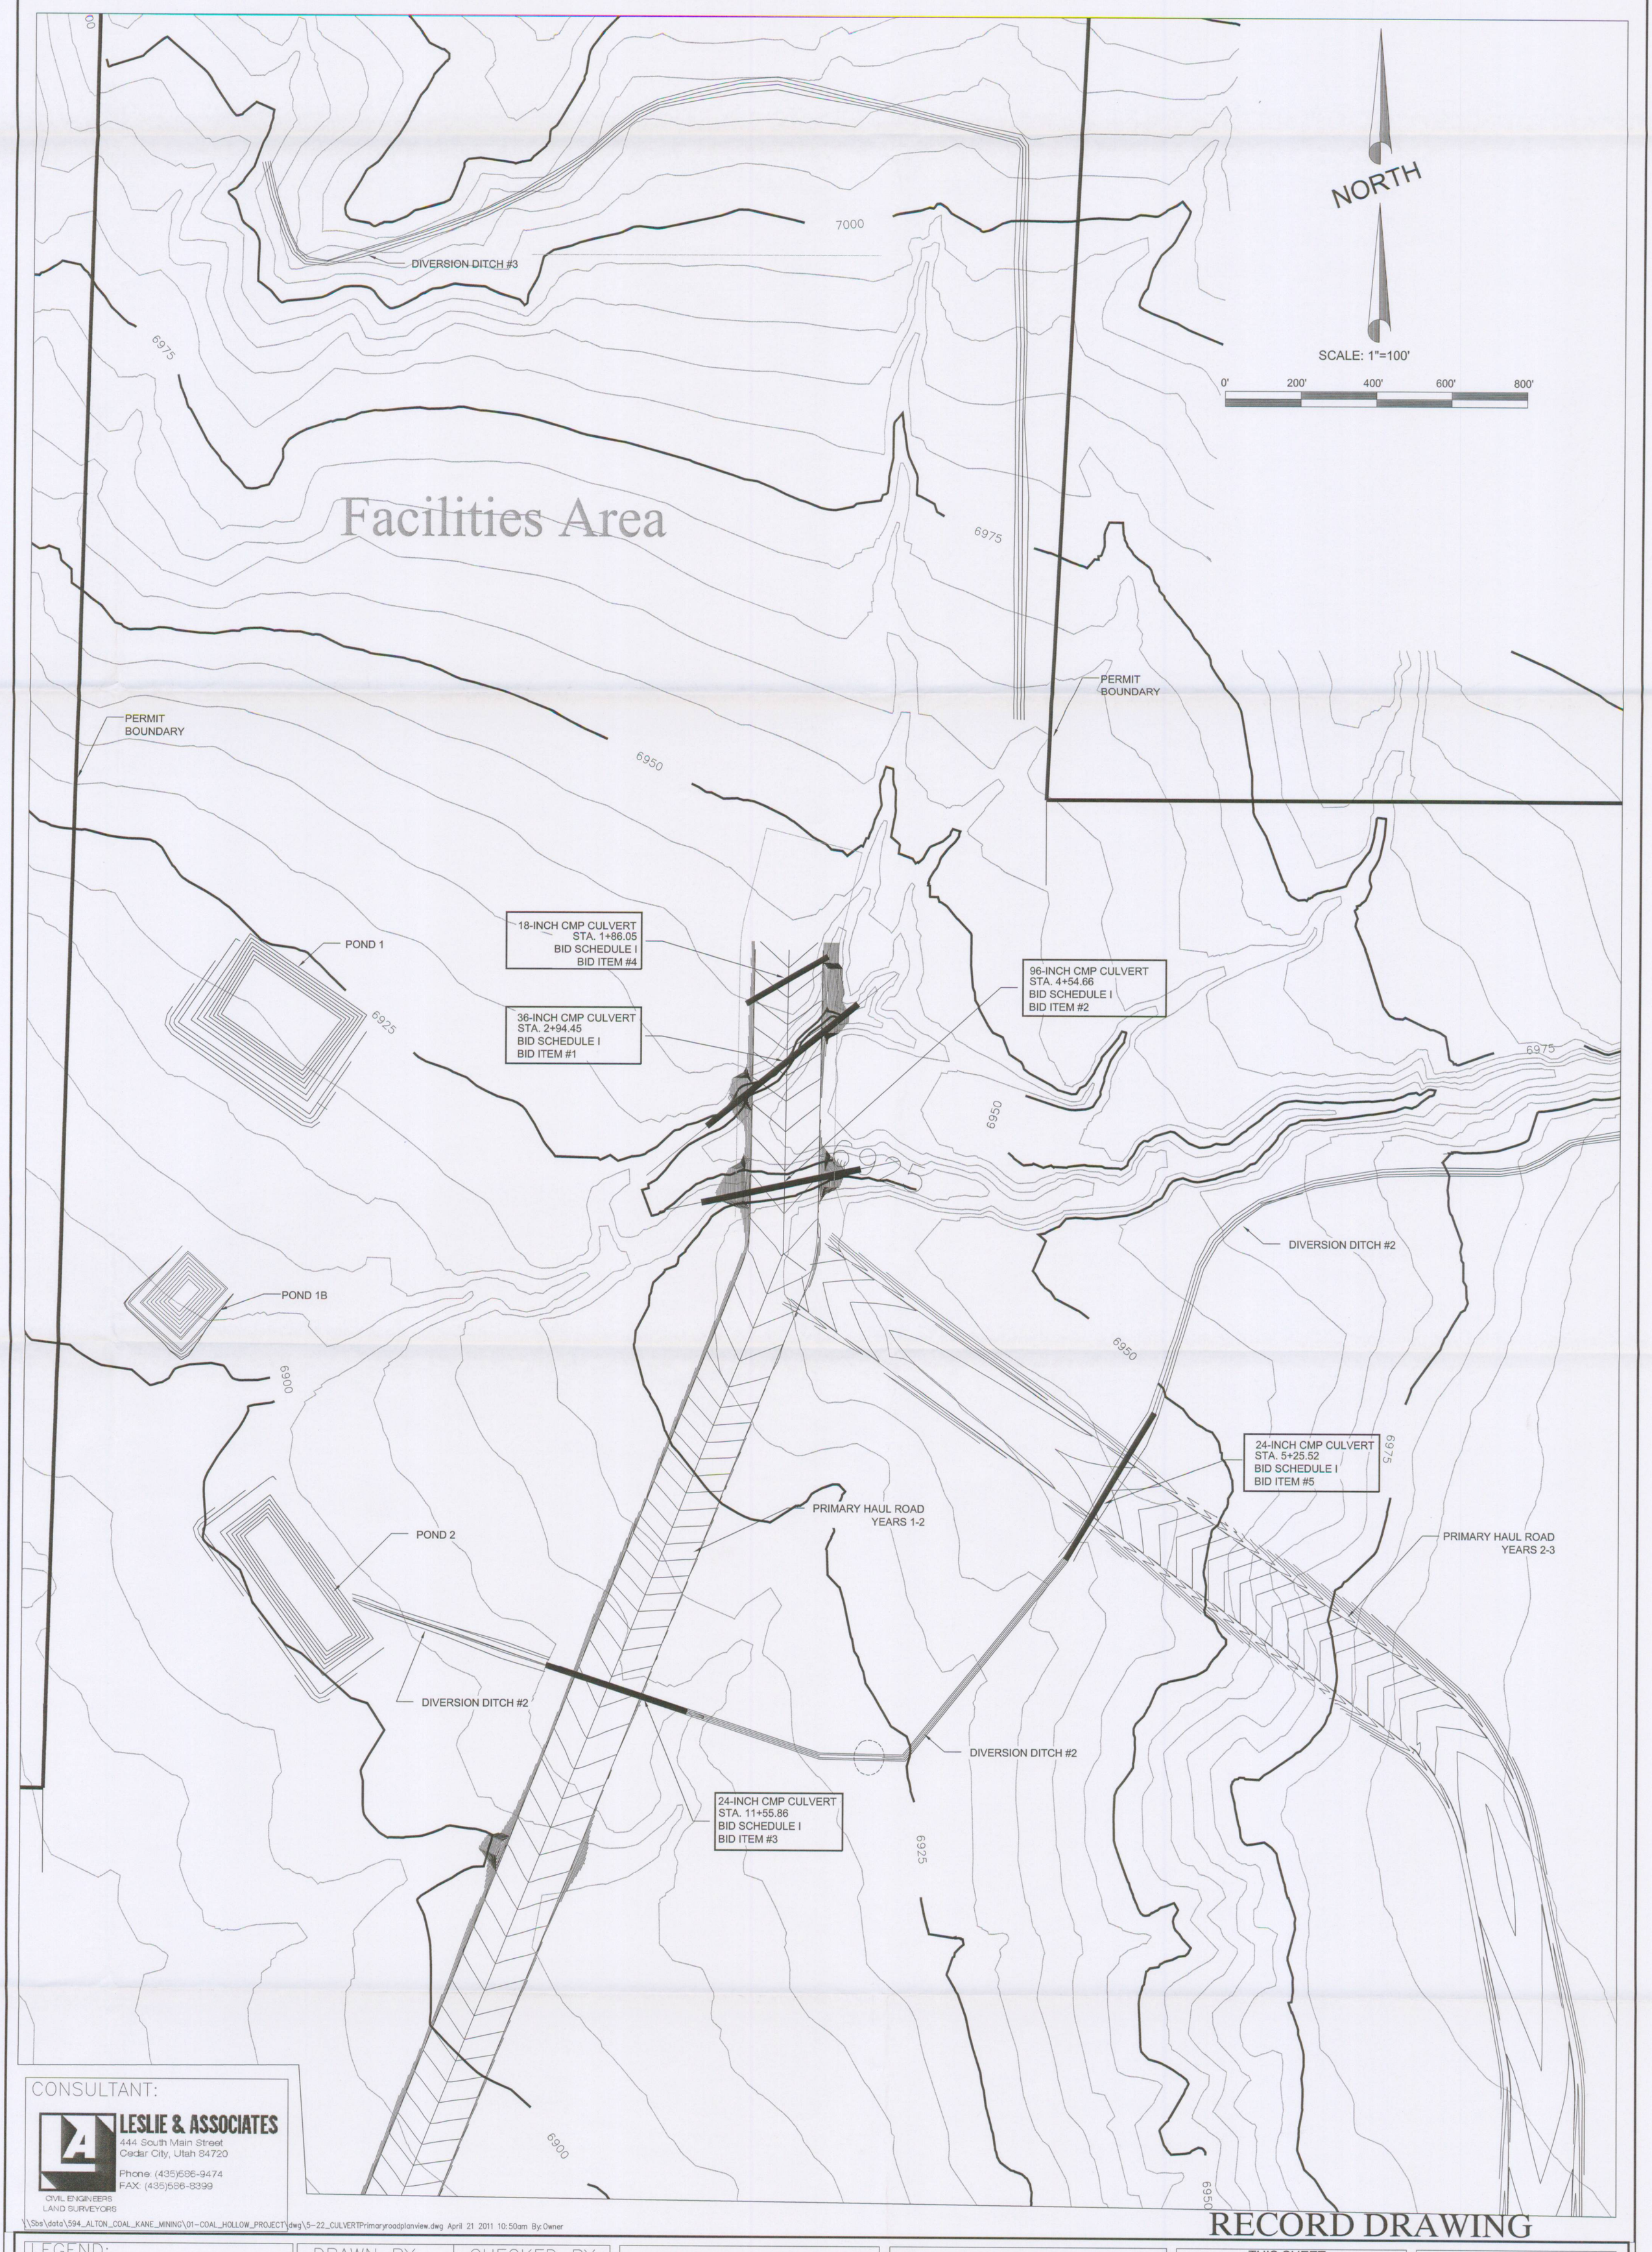

CONSULTANT:

LESLIE & ASSOCIATES
444 South Main Street
Cedar City, Utah 84720
Phone: (435)586-9474
FAX: (435)586-8399
CIVIL ENGINEERS
LAND SURVEYORS

\\Sbs\data\594_ALTON_COAL_KANE_MINING\01-COAL_HOLLOW_PROJECT\dwg\5-22_CULVERTPrimaryroadplanview.dwg April 21 2011 10:50am By: Owner

RECORD DRAWING

LEGEND:
- PERMIT BOUNDARY
- SECTION LINE
- PROPOSED SEDIMENT IMPOUNDS
- PROPOSED DIVERSION DITCHES

DRAWN BY: KRB	CHECKED BY: JPL
DRAWING:	DATE: 11/06/2010
RECEIVED JUL 05 2011 DIV. OF OIL, GAS & MINING	SCALE: 1" = 100'
JOB NUMBER: 594-01-01	

REVISIONS

DATE:	BY:
4/19/11	KRB

PRIMARY MINE HAUL ROAD CULVERT PLAN (BID SCHEDULE I)

COAL HOLLOW PROJECT
ALTON, UTAH

DRAWING: C6.0

THIS SHEET LIMITED TO HAUL ROAD CULVERTS ALL OTHER DATA IS FOR INFORMATION ONLY

LICENSED PROFESSIONAL ENGINEER No. 348930 KERRY ROBERT BENSON STATE OF UTAH
4-19-2011

Alton Coal Development
Coal Hollow Project

463 North 100 West, Suite 1
Cedar City, Utah 84720
Phone (435)867-5331
Fax (435)867-1192