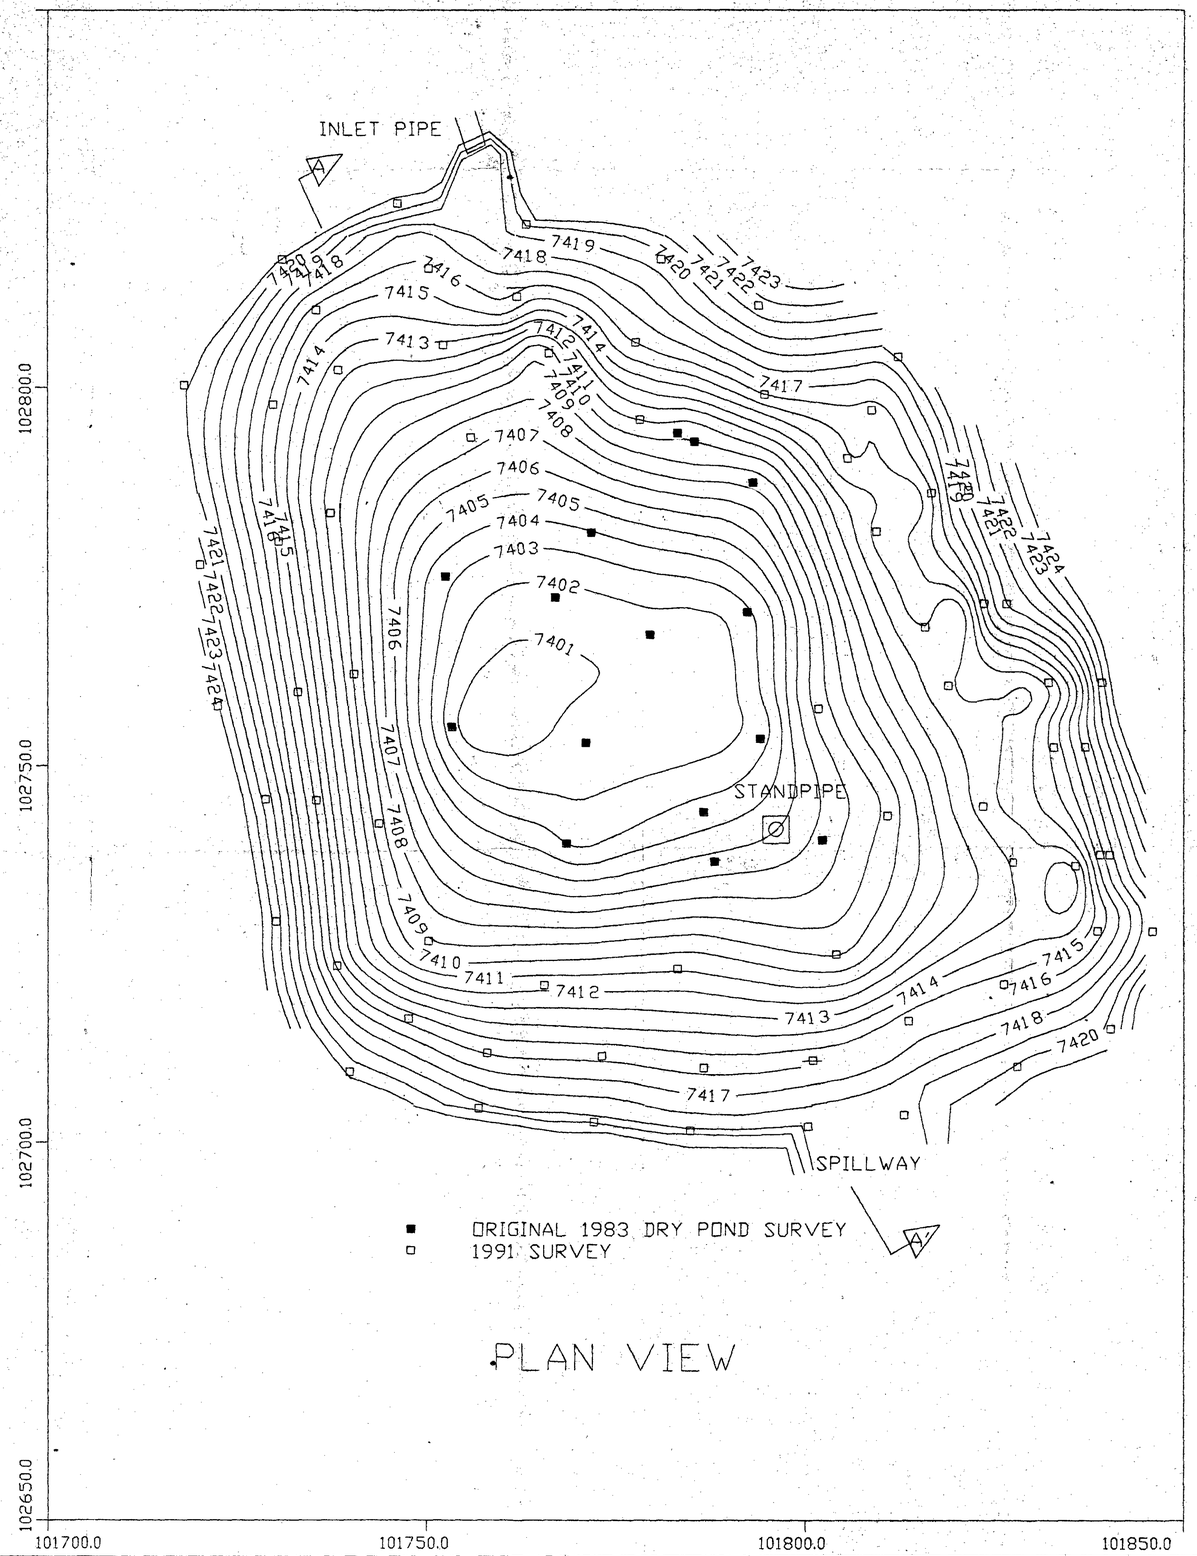

PLAN VIEW

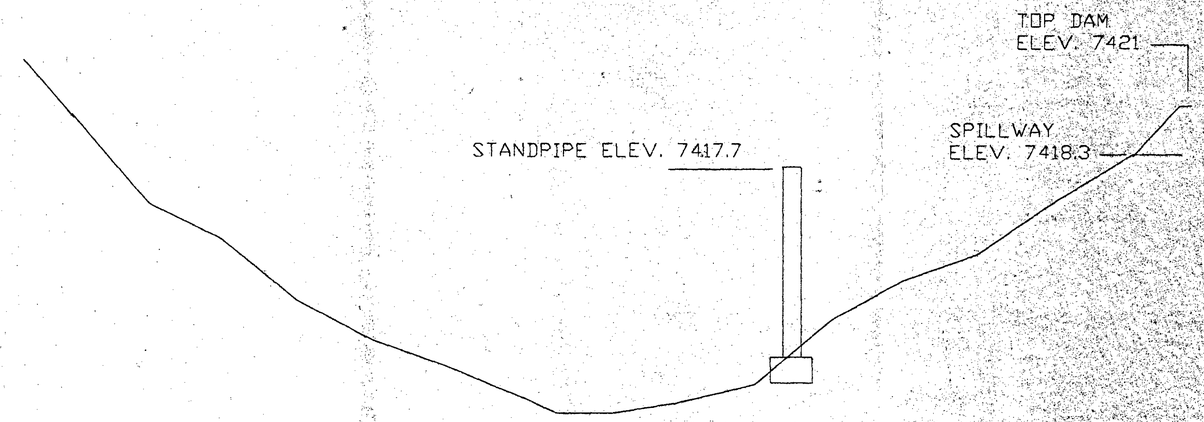

CROSS-SECTION A-A'

	VOLUME ACRE/FT	ELEVATION
EMERGENCY SPILLWAY	1.926	7418.3
PRINCIPAL SPILLWAY	1.790	7417.7
MAXIMUM SEDIMENT	0.671	7411.4
60% SEDIMENT	0.403	7408.9

I CERTIFY THAT THIS PLATE ACCURATELY DEPICTS THE MINESITE SEDIMENT POND AFTER CLEANING AND SPILLWAY MODIFICATIONS. THE SURVEYS WERE DONE AND THIS PLATE PREPARED UNDER MY DIRECT SUPERVISION.

Wesley K. Sorensen
WESLEY K. SORENSEN
P.E. NO. 5369
STATE OF UTAH
10/2/91

RECEIVED
OCT 0 4 1991
DIVISION OF
OIL GAS & MINING

N

REVISIONS OR UP-DATES			9-20-91	DATE
NO.	DATE	BY	DESIGNED BY:	
1	9-20-91	ADD	DRAWN BY:	ADD
			CHECKED BY:	
			SCALE: 1" = 10'	

Coastal States Energy Company
A SUBSIDIARY OF THE COASTAL CORPORATION
The Energy People

AS-BUILT SEDIMENT POND

SUFCO MINE

DRAWING OR MAP NUMBER: 83-5