


EXPLANATION

- ◆ Found Section Corner
- ◇ Section Corner Not Found
- ▲ Elevation Point
- ⌋ Culvert
- ▬ Graded Roads
- x-x-x- Fence
- ⊙ Location of Drill Hole
- o-o- Powerline Showing Location of Poles
- ≡≡≡ Natural Edge of Bluff
- Natural Drainage Pattern (Generalized)
- Runoff Drainage Pattern in Area of Influence After Filling of Low Areas and Grading.
- Areas to be Filled to Obtain Proper Drainage
- Straw Dike
- U Retaining Wall
- ⌋ Settling Pond (See Plate 3 for Details of Construction)
- Large Areas to be Seeded
- ~ 40 Foot Contour
- - - 10 Foot Contour
- ESTIMATED DISTURBED AREA 19 ACRES
J.R.H. 3-20-85
- FACILITIES TO REMAIN FOR
POST MINING LAND USE AREA, 3 ACRES.

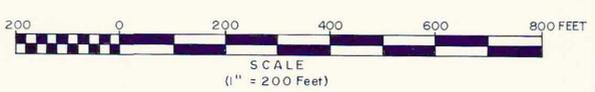

CONTOUR INTERVAL - 40 FEET
(Supplemental Contours - 10 Feet)
DATUM IS MEAN SEA LEVEL

Base and Mine Map by C.W. Shannon, 1976-78
Modified by R.S. Kopp, 1980.

RECLAMATION AND MINE MAP FOR THE BLACK HAWK COAL MINE

SUMMIT COUNTY, UTAH
SECTION 36, T. 3 N., R. 6 E., S. 1 M.